


Map No. _____ Sec. 36 Twp. 22 R. 4 W
 Well No. 1 - Sink Farm _____
Manning & Terry Company

NORTH

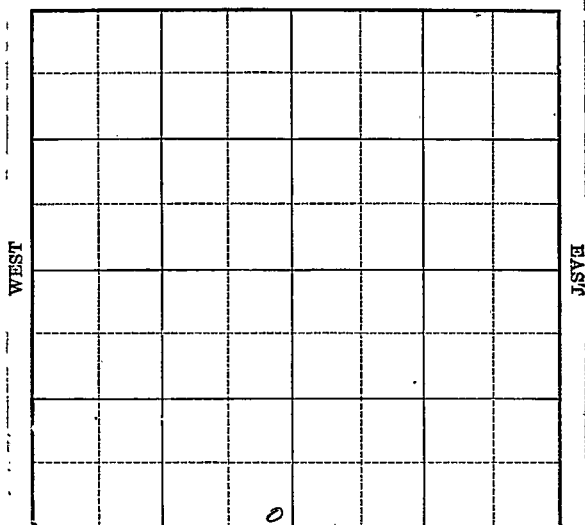

SOUTH

Location _____

Drilling Remarks _____

Rig Up _____

Drilling Remarks _____

RECORD

Cased _____ in. _____ ft.

Sand _____

Gas _____

Oil _____

Total Depth _____

PRODUCTION

1st 24 hrs. Nat. _____

1st 24 hrs. after shot _____

Gas _____ cu. ft.

Dry Hole _____

Abandoned _____

Map No. **KANSAS** Sec. 36 Twp. 22 R. 4W

Well No. 1- DIRK Farm


Manning & Terry Company

_____ Ft. from N. Line

330 Ft. from S. Line

355 Ft. from E. Line

_____ Ft. from W. Line

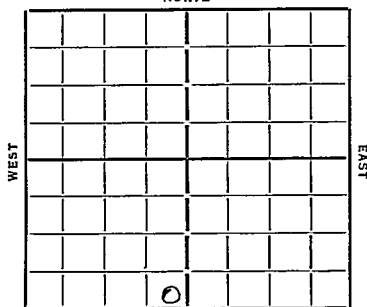

"NO RECORD"

Date
1934

REPORT

TWIN WELL

1/31

O.T. D. 3321

2/7

—

2/14

TD 3333 No Increase in Production

COMPLETED

Map No. 48 Sec. 36 Twp. 22 R. 4WWell No. 1- DickManning & Terry Companyno record shown Contractor**FIRST REPORTS**

SECTION PLAT

Ft. from N. Line

330 Ft. from S. Line355 Ft. from E. Line

Ft. from W. Line

FIRST REPORTSOW 20Location NO RECORD

Rig up.....

Drilling and Remarks:

no increase
in productionOW 20**RECORD**

Cased.....in., ...ft.

Sand.....

Gas.....

Oil.....

Total Depth 3333**PRODUCTION**

1st 24 hrs. Nat.....

1st 24 hrs. after shot.....

Gas.....Cu. Ft.

Dry Hole.....

Abandoned.....

Date

2-17-34 192 O. Manschuet Scout

Map No. 48 Sec. 36 Twp. 22 R. 4WWell No. 1-DruckManning & Terry Company

Contractor

FIRST REPORTS

Ft. from N. Line

330 Ft. from S. Line355 Ft. from E. Line

Ft. from W. Line

Twin wellOWDN

SECTION PLAT

Location

Rig up

Drilling and Remarks:

O.T.D. 33213333
gas increase**NO-RECORD**

Date

1-31-34 192

RECORD

Cased 2 in., ft.

Sand

Gas

Oil

Total Depth 3321

PRODUCTION

1st 24 hrs. Nat.

1st 24 hrs. after shot

Gas Cu. Ft.

Dry Hole

Abandoned

TWIN TO #1 BARTELO. Mannschreck Scout