

Reno

Map No. **KANSAS** Sec. *36* Twp. *22* R. *4W*

Well No. *1 Heidelberg* Farm


Hollow + Oarted Oil Company

_____ Ft. from N. Line

330' Ft. from S. Line

990' Ft. from E. Line

_____ Ft. from W. Line

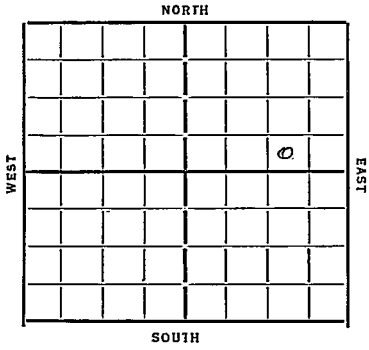

Date *1933* REPORT

- 5/10 Moving in Material*
- 5/17 Rotary Rig*
- 5/24 Reqn Rotary*
- 6/1 By 1025*
- 6/8 Top K.C. 2572 dely 2525*
- 6/15 dely 2222*
- 6/21 Chat 3314 T.D. 3335'*
- 6/28 9 M gas dely 3565'*
- 7/5 Base line 3547 Hunter 3666 1/2 T.D. 3673*
- small show oil*
- 7/12 P.B. to 3368 7 1/2 M gas show water*
- 7/19 —*
- 7/26 —*
- 8/2 Top chat 3314 T.D. 3673*
- P.B. to 3368*
- 7 M Gas*

COMPLETED

Reno

W

48 KANSAS

Map No. Sec. 36 Twp. 22 R. 4

Well No. 1 Heisebrecht

Hallow & Carter Oil Co. Company

Contractor

SECTION PLAT

FIRST REPORTS

Ft. from N. Line
330 Ft. from S. Line
990 Ft. from E. Line
Ft. from W. Line

Section plat grid with 4 columns and 4 rows, containing a small 'o' in the second row, third column.

RECORD

Location
Rig up
Drilling and Remarks:

Missing in Material

Cased in., ft.
Sand
Gas
Oil
Total Depth

PRODUCTION

1st 24 hrs. Nat.
1st 24 hrs. after shot
Gas Cu. Ft.
Dry Hole
Abandoned

Date

MAY 10 1933

CHAS. L. SHERWOOD Scout

Map No. 48 Sec. 36 Twp. 22 R. 4W

Well No. 1 - Herdebrecht

Hallow & Carter Company

Contractor

SECTION PLAT

..... Ft. from N. Line

330 Ft. from S. Line

990 Ft. from E. Line

..... Ft. from W. Line

			o

COMPLETED

Location.....

Rig up.....

Drilling and Remarks:

chat 3314
plug back
3368

7 mil gas

RECORD

Cased..... in., ft.

Sand.....

Gas.....

Oil.....

Total Depth 3673

PRODUCTION

1st 24 hrs. Nat.....

1st 24 hrs. after shot.....

Gas..... Cu. Ft.

Dry Hole.....

Abandoned.....

Date

8/7/33 Orial Mansfield Scout