


Section 36 Township 22 Range 4 W

Well No. # 1 Schroeder

Company Woody Speer et al

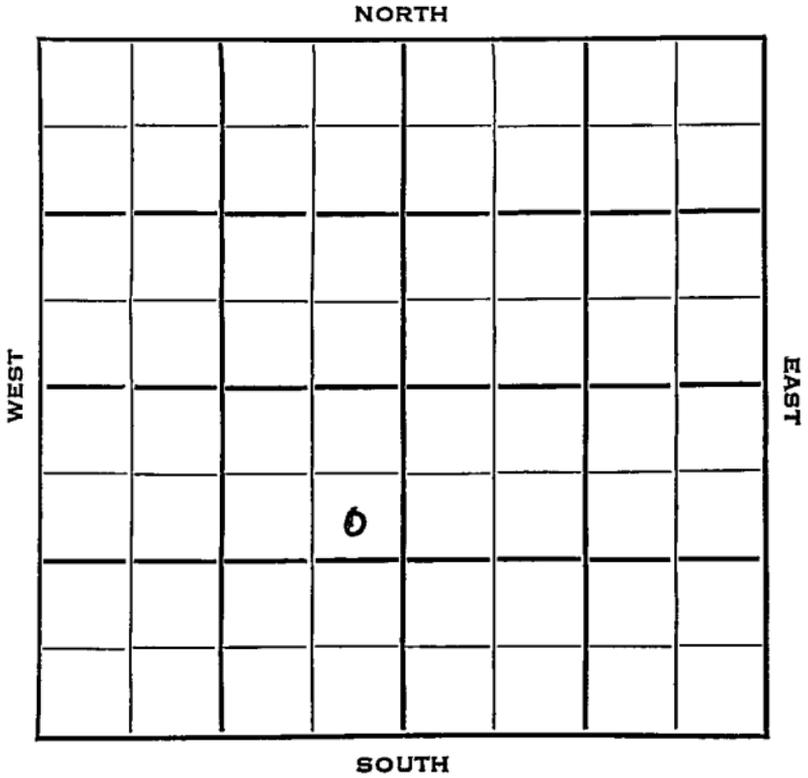

Sec. 36 Twp. 22 R. 1W

Well No. #1 Schroeder Farm

Woody Speer et al Company

Sterling Drlg. Contractor

Burrton Pool


990 Ft. from N. Line

_____ Ft. from S. Line

330 Ft. from E. Line

_____ Ft. from W. Line

SE NE SW

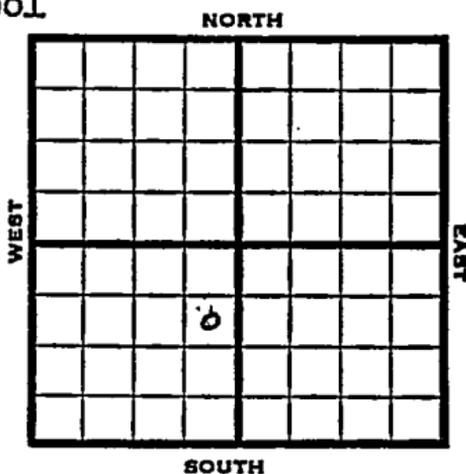

1953 Elev. 1145' REPORT

7/1 RUR
 7/8 8" @ 326 w/200
 Top 1980
 Drlg. 2 300'
 7/15 Spud6-30-53
 D&A
 TD 3371
 8" @ 326
 Top 1980, Miss 3237
 DST 3280-3320, opn 1½ hrs., gas in
 20 mins., rec. 60,000 gas, 590#
 DST 3322-29, opn 1½ hrs., rec. 30' mud
 215#
 TD 3371
 D&A

ABANDONED

County Reno State Kansas

Sec. 36 (Blk. Twp.) 22 (Sur. Rge.) 4W Map No.

Operator Woody Speer et al.

Well No. 1 Farm Schroeder

Elev. _____ Location SE NE SW

990 Ft. From N Line SW

330 Ft. From E Line Quarter

1st. Report JUL 1 1953

Completion _____

Remarks _____

Sterling Drig. - Contr.

Spudding Date _____

Drig. Data Burrton Pool

R U R

