


Section 36 Township 22 Range LW

Well No. #1 ^{PETERS}~~Freeze~~

Company Raymond Gear

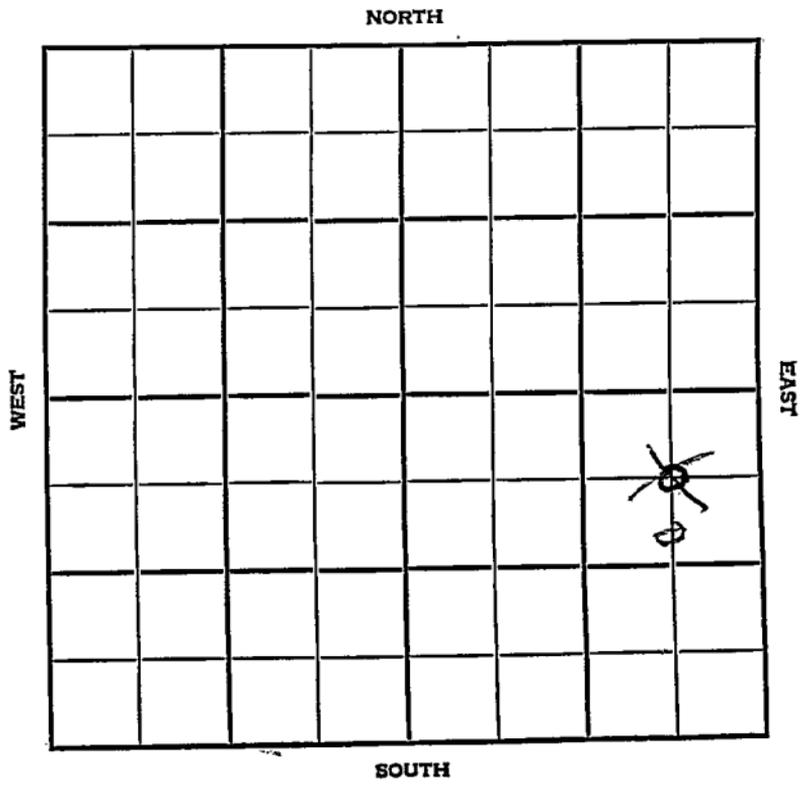

Reno KANSAS


SEC. 36	TWP. 22	R. 4W
------------	------------	----------

WELL NO. **PETERS**
1 Froese FARM

COMPANY
Raymond Gear

CONTRACTOR
Lewis Drlg.

~~660~~ ⁹⁹⁰ Ft. from N. Line
 _____ Ft. from S. Line
 660 Ft. from E. Line
 _____ Ft. from W. Line

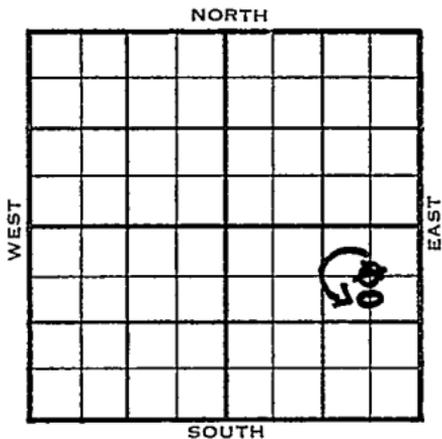

C S/2 NESE

~~C NE SE~~

1955	ELEVATION	REPORT
------	-----------	--------

4/13	MIR	
------	-----	--

County Reno State Kansas

Sec. 36 (Blk. Twp.) 22 (Sur. Rge.) 4W Map No.

Operator Raymond Gear

Well No. 1 Farm Froese

Elev. Location C NE SE

660 Ft. From N Line SE

660 Ft. From E Line Quarter

Ist. Report APR 13 1955

Completion

Remarks

Lewis D. lg. - Contr.

Spudding Date

Drlg. Data

M I R

