


Section 36 Township 22 Range 4-W

Well Number 1-Siemens

Company W.C. McBride

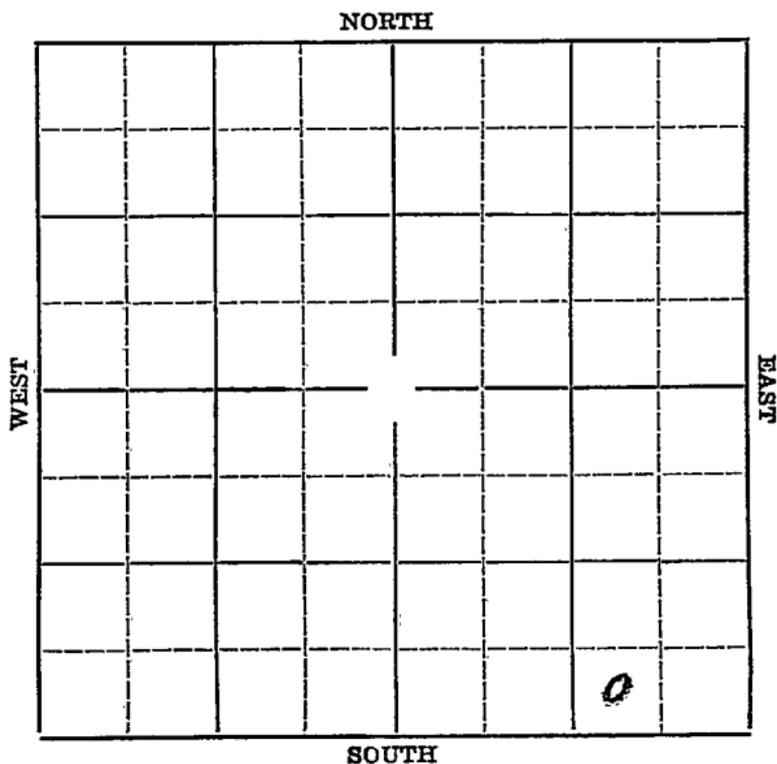

Map No. Sec. 36 Twp. 22 R. 4W

Well No. #1 Siemens Farm

W.C. McBride. Company


 Ft. from N. Line

330' Ft. from S. Line

990' Ft. from E. Line

 Ft. from W. Line

Elev. 1453

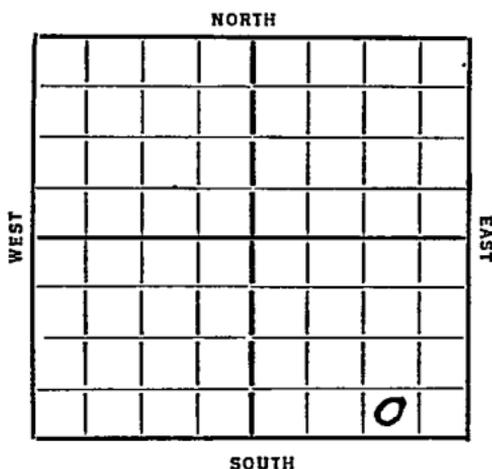

Date
1936

REPORT

5/13 Rig.

5/21 15" @ 302' .WOC.

5/28 Drlg. 2210'.

6/4 Drlg. 2962'. K.C. 2435'.

6/11 Chat 3253'. T.D. 3263'. Set 7".

Rigging up standard tools.

7/1/36-Chat 3257'.

2000 gallons acid.

T.D. 3350'.

Pump 903 bbls of oil.

COMPLETED

Map No. 48 Sec. 36 Twp. 22 R. 4W

Well No. 1 Siemens

O. C. McBride Company

Contractor

SECTION PLAT

_____ Ft. from N. Line

330 Ft. from S. Line

990 Ft. from E. Line

_____ Ft. from W. Line

FIRST REPORT

Location _____

Rig up _____

Drilling and Remarks:

Rig

RECORD

Cased _____ in., _____ ft.

Sand _____

Gas _____

Oil _____

Total Depth _____

PRODUCTION

1st 24 hrs. Nat. _____

1st 24 hrs. after shot _____

Gas _____ Cu. Ft.

Dry Hole _____

Abandoned _____

Date

MAY 13 1936

19

J. LEWIS

Scout

KANSAS

Map No. 48 Sec. 36 Twp. 22 R. 7WWell No. 1 SiemensH. C. McBride Company

Contractor

SECTION PLAT

_____ Ft. from N. Line

320 Ft. from S. Line990 Ft. from E. Line

_____ Ft. from W. Line

COMPLETED

Location _____

Rig up _____

Drilling and Remarks:

Ok 83257
2000 acid

Pump 903886

RECORD

Cased _____ in., _____ ft.

Sand _____

Gas _____

Oil _____

Total Depth 3350

PRODUCTION

1st 24 hrs. Nat. _____

1st 24 hrs. after shot _____

Gas _____ Cu Ft.

Dry Hole _____

Abandoned _____

Date

JUL 1 1936 19

S. J. LEWIS Scout