


Section 36 Township 22 Range 5-W

Well No. 2 Schroeder

Company Sinclair Prairie

NORTH

Buhler Pool

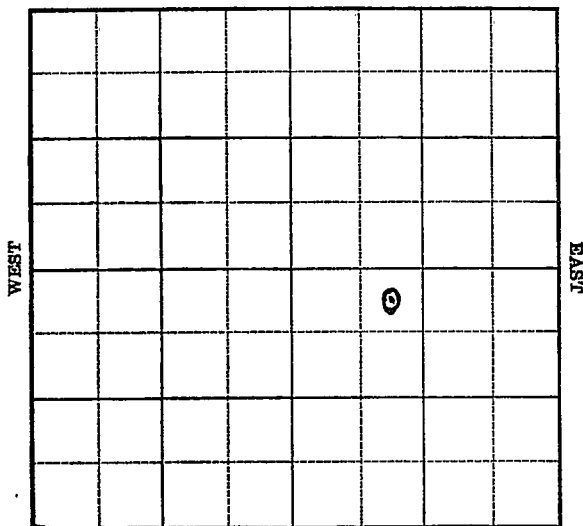

SOUTH

Map No. 48 Sec. 36 Twp. 22 R. 5WWell No. 2 SchroederSinclair Prairie Company

Contractor

FIRST REPORT

NE NW SE

330 Ft. from N. Line

_____ Ft. from S. Line

_____ Ft. from E. Line

990 Ft. from W. Line**BUHLER POOL****SECTION PLAT**

		o	

Location X

Rig up _____

Drilling and Remarks:

RECORD

Cased _____ in., _____ ft.

Sand _____

Gas _____

Oil _____

Total Depth _____

PRODUCTION

1st 24 hrs. Nat. _____

1st 24 hrs. after shot _____

Gas _____ Cu. Ft.

Dry Hole _____

Abandoned _____

Date

APR 26 1939H. D. Hatfield Scout

Reno

Map No. 48 Sec. 36 Twp. 22 R. 5W

Well No. 2 Schroeder

Sinclair Prairie Company

Contractor

COMPLETED

SECTION PLAT

330 NE NW SE
Ft. from N. Line

_____ Ft. from S. Line

_____ Ft. from E. Line

990 Ft. from W. Line

		o	

BUHLER POOL

Location _____

Rig up _____

Drilling and Remarks:

Viola 3903

Sump 3921

7" @ 3903

P 8 547

Pump

RECORD

Cased _____ in., _____ ft.

Sand _____

Gas _____

Oil _____

Total Depth 3921 1/2

PRODUCTION

1st 24 hrs. Nat. _____

1st 24 hrs. after shot _____

Gas _____ Cu. Ft.

Dry Hole _____

Abandoned _____

Date

JUN 7 1939

19

S. J. LEWIS

Scout