


Section 36 Township 22 Range 5-W

Well No. 2 Hegarty "B"

Company Westgate-Greenland

NORTH **Buhler Pool**

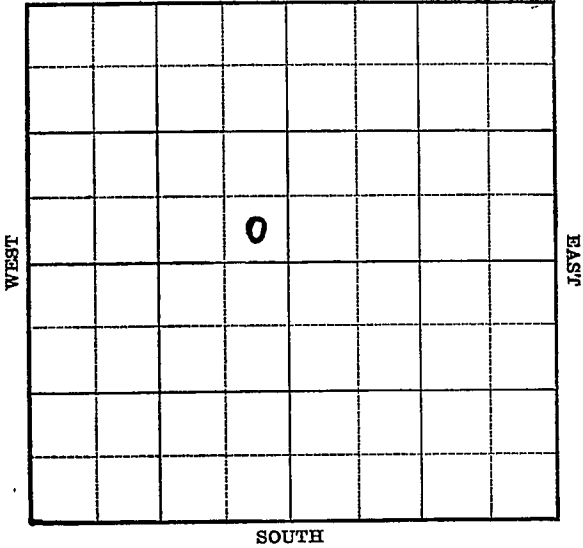

Sec. 36 - Twp. 22 R. 5-W

Well No. #2 Hegarty "B" Farm

Westgate-Greenland Company

(Buhler)


_____ Ft. from N. Line

330 Ft. from S. Line

330 Ft. from E. Line

_____ Ft. from W. Line

Elev. 1560

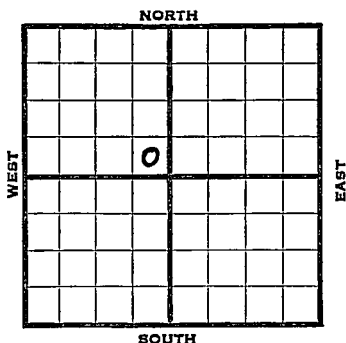

1939	REPORT
4/12	B.R.R.
4/21	12" - 160' Drlg. 980'
4/28	Drlg. 3100'
5/12	Viola 3909' 7" - 3916'
	Wilcox 3924' T.D. 3927'
	700' oil 8 hrs.
5/19	T.D. 3933' Pump 11 oil 35 water in 35 hrs.
	Shot 10 qts. 3329-31' C. O.
5/26	T.D. 3936' 2000' water. S.D.
6/1	" " " " " "
6/8	" " " " " "
6/16	" " " " " "
6/23	" " " " " "
	-
6/28	Wilcox 3924'
	2000' water.
	T.D. 3936'
	ABANDONED

Map No. 48 Sec. 36 Twp. 22 R. 5WWell No. 2 Hegarty "B"Westgate-Greenland Company

Contractor

FIRST REPORT

SECTION PLAT

SE NW

_____ Ft. from N. Line

330 Ft. from S. Line330 Ft. from E. Line

_____ Ft. from W. Line

		0	

BUHLER POOL

Location _____

Rig up _____

Drilling and Remarks:

BRR
/

RECORD

Cased _____ in., _____ ft.

Sand _____

Gas _____

Oil _____

Total Depth _____

PRODUCTION

1st 24 hrs. Nat. _____

1st 24 hrs. after shot _____

Gas _____ Cu. Ft.

Dry Hole _____

Abandoned _____

Date

APR 12 1939 19

H. D. Hatfield Scout

Reno

KANSAS

Map No. 48 Sec. 36 Twp. 22 R. 5W

Well No. 2 Hegarty "B"

Westgate-Greenland Company

Contractor

ABANDONED

SE NW

_____ Ft. from N. Line

330 Ft. from S. Line

330 Ft. from E. Line

_____ Ft. from W. Line

SECTION PLAT

BUHLER POOL

Location _____

Rig up _____

Drilling and Remarks:

*Wells 3924
2000' Water*

RECORD

Cased _____ in., _____ ft.

Sand _____

Gas _____

Oil _____

Total Depth 3936

PRODUCTION

1st 24 hrs. Nat. _____

1st 24 hrs. after shot _____

Gas _____ Cu. Ft.

Dry Hole _____

Abandoned _____

Date
JUN 26 1939

19

S. J. LEWIS Scout