


Section 36 Township 22 Range 5-W

Well No. 1 L. Wood

Company Derby

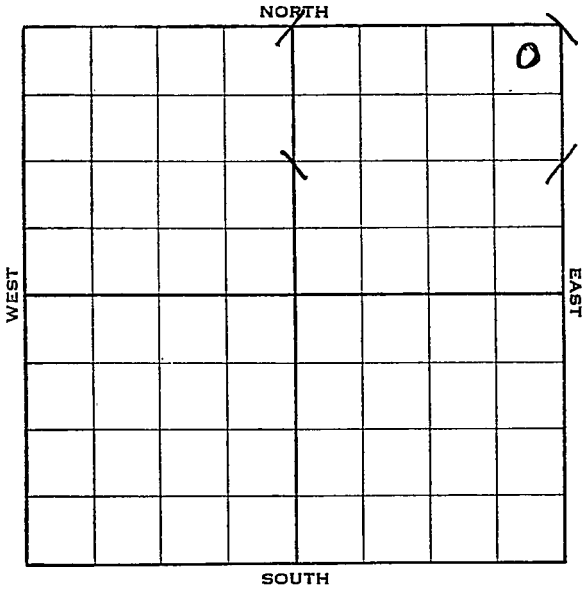


Sec. 36 Twp. 22 R. 5-7Well No. #1 L. Wood FarmDerby Company330 Ft. from N. Line

Ft. from S. Line

330 Ft. from E. Line

Ft. from W. Line

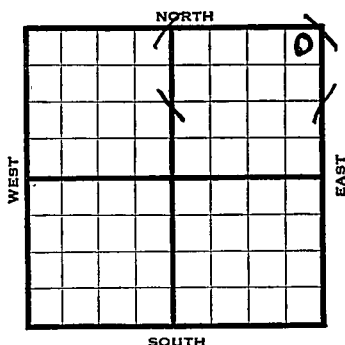

Elev. 1531

1938	REPORT
4/6	Location
4/15	"
4/22	R U R
4/29	12" @ 154'.. Drlg. 1360'..
5/6	Lans. 2708'. Drlg. 2825'.
5/12	Miss. 3390'. Drlg. 3435'.
5/16	Top Simpson sand 3907-09 T.D.
	Fair stain 3908-09
	To run 7" casing - (Tel) . . .
5/20	Misner 3759'. Hunton 3764'.
	Viola 3885' - stains of oil.
	Simp. dolomite 3904'.
	Simp. sand 3905'.
	T.D. 3907'. Fair stains oil.
	5" @ 3903'. RUST.
5/27	T.D. 3909'. Swab 7½ oil & 1/4
	bbls. wtr. in 14 hrs.
	100 acid. No help.
	Will shoot.
6/3	Shot 5 qts. 3905-09'.
	3600' oil. Fishing.

OVER

1938

6/10 Drlg. up sand pump.

6/17 " " " "

6/24 " " " "

7/1 C.O. " " "

7/6 5" - 3903'..

Simp. 3905'

T. D. 3909'

100 acid.

Shot 5 qts.

Pump 121 bbls. 4 hrs. & 132 bbls.

4 hrs.

Potential 724 bbls.

COMPLETED

Reno KANSAS

Map No. 48 Sec. 36 Twp. 22 R. 5W

Well No. 1 L. Wood

Derby Company

FIRST REPORT Contractor

NE/C

330 Ft. from N. Line

_____ Ft. from S. Line

330 Ft. from E. Line

_____ Ft. from W. Line

SECTION PLAT

Location X

Rig up _____

Drilling and Remarks:

RECORD

Cased _____ in., _____ ft.

Sand _____

Gas _____

Oil _____

Total Depth _____

PRODUCTION

1st 24 hrs. Nat. _____

1st 24 hrs. after shot _____

Gas _____ Cu. Ft.

Dry Hole _____

Abandoned _____

Date

APR 6 - 1938

19

H. D. Hatfield Scout

Reno

KANSAS

Map No. 48 . Sec. 36 Twp. 22 R. 5W

Well No. 1 L. Wood

Derby

Company

Contractor

COMPLETED

NE/C

SECTION PLAT

330 Ft. from N. Line

_____ Ft. from S. Line

330 Ft. from E. Line

_____ Ft. from W. Line

			0

Location _____

Rig up _____

Drilling and Remarks:

*100 Acid
shot 5 gals*

Pump 12 1/4 x 13 1/4

POT 724

RECORD

Cased 5 in., 3903 ft.

Sand Simp 3905

Gas _____

Oil _____

Total Depth 3909

PRODUCTION

1st 24 hrs. Nat. _____

1st 24 hrs. after shot _____

Gas _____ Cu. Ft.

Dry Hole _____

Abandoned _____

Date

JUL 6 - 1938

19

H. D. Hatfield

Scout