

Company Duke & Wood

NORTH

WEST

EAST

4

SOUTH

Pawnee KANSAS

SEC.	TWP.	R.
36	22	16W ✓

WELL NO.

ISchartz

FARM

COMPANY

Duke & Wood

CONTRACTOR

Duke & Wood


Wildcat

330 Ft. from N. Line

Ft. from S. Line

330 Ft. from E. Line

Ft. from W. Line

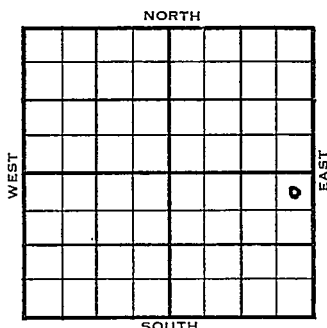

NE NE SE

1954	ELEVATION 2012'	REPORT
------	--------------------	--------

4/14 Drlg. 2107'

4/28 Spud 4-9-54

D & A

TD 4154'

8" @ 240'

Anhy 986', Heeb 3489', Br. Lime 3608'

Lans 3618', Cong 3959',

DST 3951'-4011' opn 1 hr, rec 55' Mud

175# Viola 3967' Simp 4060'

DST 4056'-90' opn 1 hr, rec 40' Mud

1100# Arb 4129'

TD 4154'

D & A

ABANDONED

County **Pawnee** State **Kansas**

Sec. 36 (Blk. Twp.) 22 (Sur. Rge.) 16W Map No.

Operator **Duke & Wood**

Well No. 7 Farm Schertz

Elev.	Location	NE	NE	SE
-------	----------	----	----	----

FIRST REPORT

330 Ft. From N Line SE

330 Ft. From E Line Quarter

1st. Report APR 14 1954

Completion


Remarks

Duke & Wood - Contr.

Spudding Date.

Drig. Data Wildcat

drlg. 2107

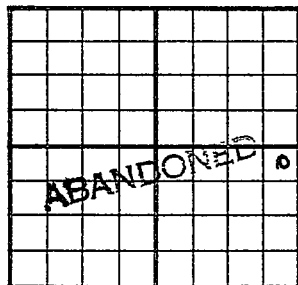County Pawnee State KansasSec. 36 (Blk.
Twp.) 22 (Sur.
Rge.) 16W Map No.Operator Duke & WoodWell No. 1 Farm SchartzElev. 2012 Location NE NE SE330 Ft. From N Line SE330 Ft. From E Line Quarter

1st. Report

Completion APR 28 1954Remarks WildcatDuke & Wood - Contr.Spudding Date 4-9-54Drlg. Data D & A TD 41548" @ 240 Anhy 986 Heeb. 3489Br. lime 3608 Lans. 3618 Cong. 3959DST 3951-4011 open 1 hr. Rec. 55' mud175# Viola 3967 Simp. 4060DST 4056-90 open 1 hr. Rec. 40' mud1100 # Arb. 4129 TD 4154D & A

J. G. McGEHEE