

Section 36 Township 22 Range 17 WWell No. #1 MacdonnelCompany Honaker & Colorado O & G

NORTH

WEST

EAST

0							

SOUTH

Pawnee

KANSAS

SEC.	TWP.	R.
36	22	17W

WELL NO.

#1 Macdonnel

FARM

COMPANY

Honaker & Colorado O & G

CONTRACTOR

Honaker

Semi Wildcat


_____ Ft. from N. Line

_____ Ft. from S. Line

_____ Ft. from E. Line

_____ Ft. from W. Line

NW NW SW

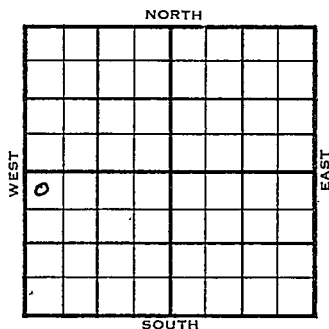

1955

ELEVATION

2054'

REPORT

8/31

Comm 8-30-55

10/19

Comm 8-30-55

8 5/8" @ 249/175

L 3723

shly 4126

Cong ch 4149

V 4244

TD 4247

DST 4149-58 open 1 hr rec 90' o & gcm

1360/30" DST 4162-82 open 80 min

rec 240' gas 30' M & w 300' wtr

1300/30" 5 1/2" @ 4246 CO 27/4160-72

B/1 bw 2 hr 500 A S/12 bf 80% wtr

dec to 24% F/6 boph frac

F/52 boph Comp BHB F/2026 bopd 2% wtr


COMPLETED

County Pawnee

Elev. _____

Sec. 36Twp. 22Rge. 17WCompany Honaker & Colorado O & GFarm Name MacdonnellNo. 1

TOPS	DEPTH	LOG	DATUM	Loc. in Sec. _____
Anh.				NW NW SW
Tr.				
Dg.				
Bl.				
L.				
K.C.				Geol. _____
B.K.C.				Contr. _____
Ce.				<u>Honaker</u>
C.				
M.				Pool _____
M.				<u>Semi Wildcat</u>
K.				
Mz.				
Mo.				
V.				
S.				
S.				
A.				
R.				
Pe.				
G.				
T.D.				

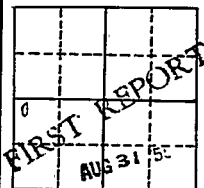Date Comm. 8-30-55

Co.

Lse.

No.

Sec.

T.

R.

County Paynee Elev. 2054
 Sec. 36 Twp. 22 Rge. 17W
 Company Honaker Drlg. & Colo. O & G
 Farm Name Macdonnell No. 1

TOPS	DEPTH	LOG	DATUM	Loc. in Sec.
Anh.				NW NW SW
Tr.				
H.				
Tr.				
Dg.				
Bl.				
L.	3723		1669	Geol.
K.C.				Contr.
B.K.C.				
Ce.				
C. <u>sh V₁</u>	4126		2072	Honaker
M. <u>Comp. V₂</u>	4149		2095	Pool
M.				Semi Wildcat
K.				
Mz.				
Me.				
V.	4244		2190	
S.				
S.				
A				
R.				
Pe.				
G.				
T.D.	4247			

Date Comm. 8-30-55 OCT 19 1955
8 5/8" @ 249/175 DST 4149-58
open 1 hr. rec. 90' o & gcm 1360/30"
DST 4162-82 open 80 min. rec. 240'
gas 30' m & w 300' wtr. 1300/30"
5 1/2" @ 4246 CO 27/ 4160-72 B/ 1 bw
2 hr. 500 A S/ 12 bf 80% wtr.
dec. to 24% F/ 6 boph frac
F/ 52' boph Comp. BHB F/ 2026 bopd 2%