


Reno
 Map No. **KANSAS** Sec. *36* Twp. *22* R. *4^W*
 Well No. *Engler et al* Farm _____ Company _____

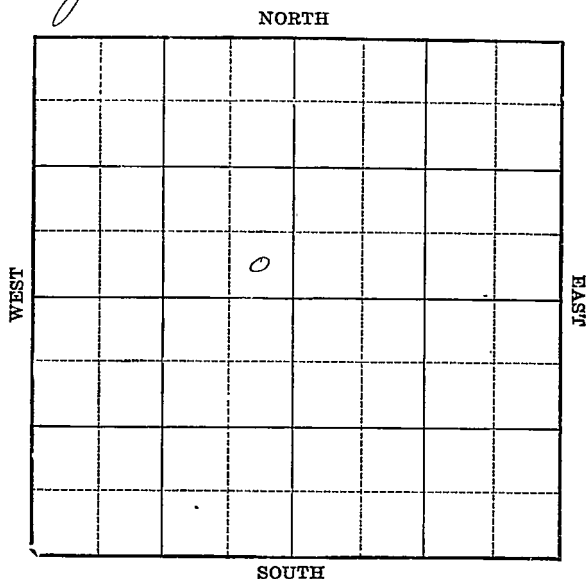

Location _____
 Drilling Remarks _____

Rig Up _____
 Drilling Remarks _____

RECORD


Cased _____ in. _____ ft.
 Sand _____
 Gas _____
 Oil _____
 Total Depth _____

PRODUCTION

1st 24 hrs. Nat. _____
 1st 24 hrs. after shot _____
 Gas _____ cu. ft.
 Dry Hole _____
 Abandoned _____

Reno
 Map No. **KANSAS** Sec. *36* Twp. *22* R. *4^W*
 Well No. *1- Balzer* Farm
Engler et al Company

_____ Ft. from N. Line
330 Ft. from S. Line
330 Ft. from E. Line
1931 Ft. from W. Line

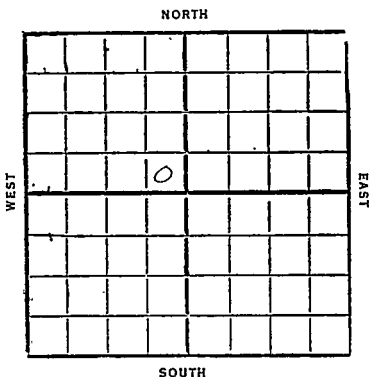

Date	REPORT
<i>12/2</i>	<i>Reg.</i>
<i>12/9</i>	<i>Reg. up</i>
<i>12/16</i>	<i>Reg.</i>
<i>12/22</i>	—
<i>12/30</i>	—
<i>1932</i>	
<i>1/6</i>	—
<i>1/13</i>	—
<i>1/20</i>	—
<i>1/27</i>	<i>Regn up</i>
<i>2/3</i>	—
<i>2/10</i>	—
<i>2/17</i>	—
<i>2/26</i>	—
<i>3/2</i>	<i>Rigged up & STD</i>
<i>3/9</i>	— <i>4/27</i> — <i>6/15</i> —
<i>3/16</i>	— <i>5/4</i> — <i>6/22</i> —
<i>3/22</i>	— <i>5/11</i> — <i>6/29</i> —
<i>3/30</i>	— <i>5/18</i> — <i>7/6</i> —
<i>4/6</i>	— <i>5/25</i> — <i>7/13</i> —
<i>4/13</i>	— <i>6/11</i> — <i>7/20</i> —
<i>4/20</i>	— <i>6/18</i> — <i>7/27</i> —

8/3- Regd up & SD

8/10

8/17 —

8/24 —

8/31 —

9/7 —

9/14 —

9/21 —

9/30 —

10/5 —

10/12 —

10/19 —

10/26 —

11/2 —

11/9 —

11/16 —

11/23- Abandon loc

48 **KANSAS** Sec. 36 Twp. 22 R. 14 W
 Reno
 Map No. 1 Balzer
 Well No. Engler & al Company
 Contractor

FIRST REPORTS

.....Ft. from N. Line
 330 Ft. from S. Line
 330 Ft. from E. Line
Ft. from W. Line

SECTION PLAT

	0		

Location.....

Rig up.....

Drilling and Remarks:

R.O.S.

RECORD

Cased.....in., ...ft.

Sand.....

Gas.....

Oil.....

Total Depth.....

PRODUCTION

1st 24 hrs. Nat.....

1st 24 hrs. after shot.....

Gas.....Cu. Ft.

Dry Hole.....

Abandoned.....

Date

DEC 2 1931

CHAS. L. SHERWOOD

192

Scout

48 KANSAS

Map No. Reno Sec. 36 Twp. 22 R. 4 W

Well No. 1 Balzer

Engler & Co Company

Contractor

COMPLETE

Ft. from N. Line


330 Ft. from S. Line

330 Ft. from E. Line

Ft. from W. Line

ABANDONED

SECTION PLAT

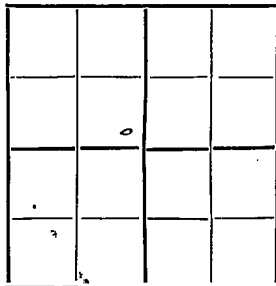

Location

Rig up

Drilling and Remarks

Abandoned Location

RECORD

Cased in., ft.

Sand

Gas

Oil

Total Depth

PRODUCTION

1st 24 hrs. Nat.

1st 24 hrs. after shot

Gas Cu. Ft.

Dry Hole

Abandoned ✓

Date

NOV 23 1932 CHAS. L. SHERWOOD Scout