

Section 4 Township 22 Range 13 WWell No. # 1 GatesCompany Derby Drlg.

NORTH

					0		

SOUTH

WEST

EAST

Stafford KANSAS

Sec. 4 Twp. 22 R. 13 W

Well No. # 1 Gates Farm

Derby Drlg. Company

Rocket Drlg. Contractor


990 Ft. from N. Line

 Ft. from S. Line

 Ft. from E. Line

990 Ft. from W. Line

SE NW NE

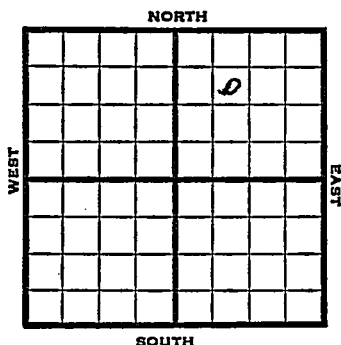

1951. Elev. 1894' REPORT


12/12 MIR

1952
2/6

Spud 12-12-51
Oil Well TD 3759
8" @ 285 Heeb. 3240
Br lime 3372 Lans. 3384
Cong. 3647
DST 3643-77 opn 1 hr
Rec. 3600' gassy oil
Simp sh 3709 Simp sd 3726
Arb. 3756 5" @ 3757
TD 3759 24/3728-36 SSO
24/3701-13 SSO 16/3690-96 SSO
24/3669-78 HFO Comp. 659 bopd

COMPLETED

J. E. TYRA

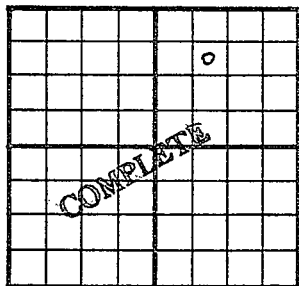County Stafford State KansasSec. 4 (Blk. 22) (Sur. 13W) Map No. 13WOperator Derby Drlg.Well No. 1 Farm GatesElev. 1894 Location SE NW NE990 Ft. From N Line NE990 Ft. From W Line Quarter

1st. Report

Completion FEB 6 1952

Remarks

Rocket Drlg. - Contr.Spudding Date 12-12-51Drlg. Data Oil well TD 37598" @ 285 Heeb. 3240 Br. lime 3372Lans. 3384 Cong. 3647 DST 3643-77open 1 hr. Rec. 3600' gassy oilSimp. sh. 3709 Simp. sd. 3726 Arb. 37565" @ 3757 TD 3759 24/ 3728-36 SSO24/ 3701-13 SSO 16/ 3690-96 SSO24/ 3669-78 HFO Comp. 659 bopd

J. G. McGEHEE