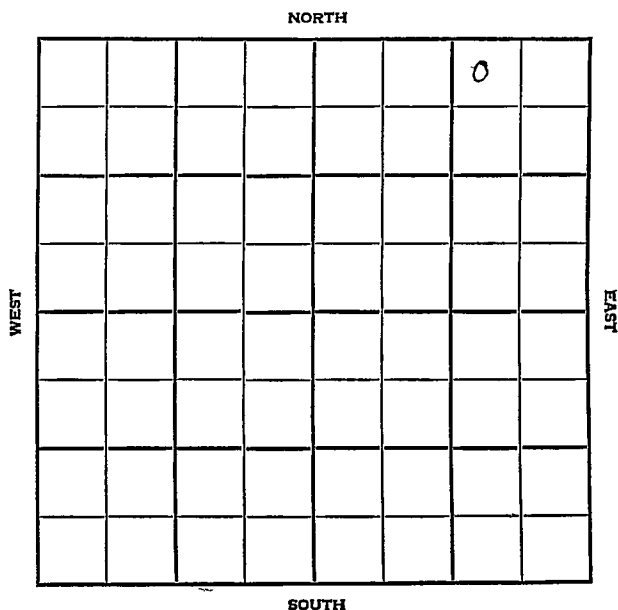


Section 4 Township 22 Range 11 WWell No. #1 GartungCompany Phillips Pet.

Stafford

KANSAS

SEC.	TWP.	R.
4	22	14W

WELL NO.

#1 Gartung

FARM

COMPANY

Phillips Pet

CONTRACTOR

Sterling

Wildcat


Ft. from N. Line

Ft. from S. Line

Ft. from E. Line

Ft. from W. Line

NW NE NE

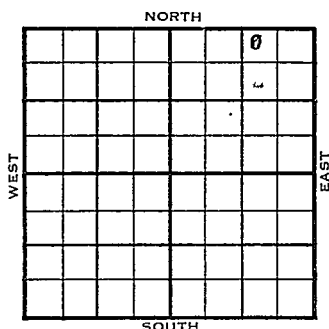

1955

ELEVATION

1944.8

REPORT

FIRST REPORT

8/10

Comm: 8-6-55

9" @420/300 Drlg: 1550

8-24

DST 3590-3605, open 1 hr., Rec. 10' mud
370/15"DST 3618-25, open 1 hr. Rec. 35' muddy
sw 0/15"DST 3778-85, open 45 min. Rec. 125' mud.
D & A

H. 3306, 3304, 1360, Tr. 3327, 3326, 1382,

Dg. 3346, 3344, 1400, B.L. 3425, 3423, 1479

L. 3435, 3433, 1489, B.K.C. 3666, 3664,

1720, Ce. Detri, 3710, 1766, C. 3710, 1766

V. 3727, 3717, 1773, S. Sh, 3756, 1812,

S. sd. 3778, 1834, A 3809, 3806, 1862,

T.D. 3860

ABANDONED

County Stafford Elev. _____
 Sec. 4 Twp. 22 Rge. 14W
 Company Phillips Pet.
 Farm Name Gartung No. 1

TOPS

DEPTH

LOG

DATUM

Loc. in Sec. _____

Anh.

NW NE NE

Tp.

H.

Tr.

Dg.

Bl.

L.

K.C.

Geol. _____

B.K.C.

Ce.

Contr. _____

C.

Sterling

M.

M.

Pool _____

K.

Wildcat

Mz.

Mq.

V.

S.

S.

A.

R.

PE.

G.

T.D.

AUG 10 '55

FIRST REPORT

Date Comm. 8-6-559" @ 420/300 drlg. 1550

13

County Stafford Elev. 1944
 Sec. 11 Twp. 22 Rge. 11W
 Company Phillips Pet.
 Farm Name Gartung No. 1

TOPS	DEPTH	LOG	DATUM	Loc. in Sec.
Anb.				NW NE NE
Tr.				
H.	3306	3204	1360	
Tr.	3327	3224	1382	
Dg.	3346	3344	1400	
BL.	3455	3453	1479	
L.	3435	3433	1489	
K.C.				Geol.
B.K.C.	3666	3664	1720	Contr.
Ce. <u>Detri</u>	3710	1	1766	
C.		3710	1766	Sterling
M.				Pool
M.				Wildcat
K.				
Mz.				
Mq.				
V.	3727	3717	1773	
S. <u>sh</u>	3756		1812	
S. <u>sd</u>	3778		1834	
A.	3809	3806	1865	
R.				
Pe.				
G.				
T.D.	3860			

Date Comm. 8-6-55 AUG 24 1955
9" @ 120/300 DST 3590-3605 open 1 hr.
Rec. 10' mud 370/15" DST 3618-25
open 1 hr. Rec. 35' muddy sw 0/15"
DST 3778-85 open 45 min. Rec.
125' mud

D & A