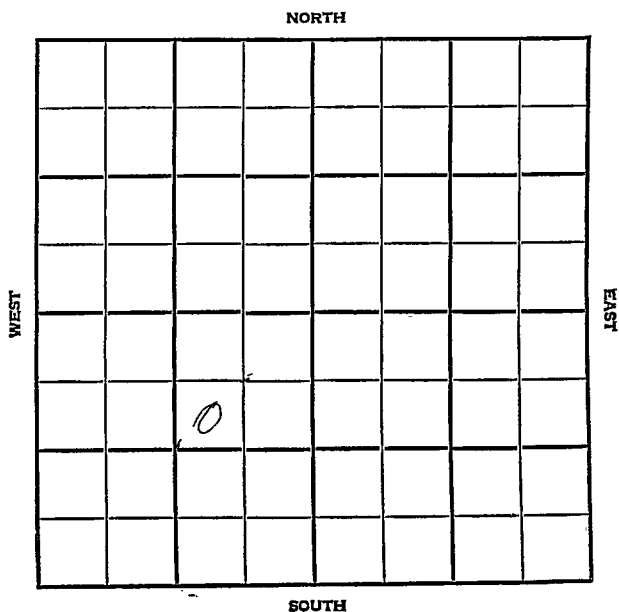


Section 4 Township 22 Range 16WWell No. #1 BaxterCompany A.F. Brann

Pawnee

KANSAS

SEC. 4	TWP. 22	R. 16W
-----------	------------	-----------

WELL NO.

#1 Baxter

FARM

COMPANY

A.F. Brann

CONTRACTOR

Musgrove

Larned


Ft. from N. Line

1739 Ft. from S. Line

Ft. from E. Line

1710 Ft. from W. Line

SW NE SW

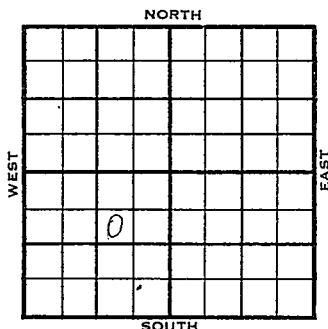

1956	ELEVATION 1997'	REPORT
5-16	Comm. 5-9-56 8" @ 982 w/500 Drilg. 2740'	
5-23	DST 3849-53 op 20 min. rec. 20' mud, BHP 1360/15" DST 3850-68 op 1 hr. rec. 1980' sulph. wtr. / 360' sulp. wtr., BHP 1200/20" D & A H. 3395', BL. 3501', L. 3509', S. 3838' A. 3848'. TD 3868'	

ABANDONED

County Paynee Elev. _____
Sec. 4 Twp. 22 Rgs. 16W
Company A. R. Brann
Farm Name Baxter No. 1

TOPS	DEPTH	LOG	DATUM	Loc. in Sec.
Anh.				SW NE SW
Tr.				1739' SL
H.				1710' WL
Tr.				
Dg.				
Bl.				
L.				Geol.
K.C.				
B.K.C.				Contr.
Ce.				Musgrove
C.				
M.				
M.				Pool
K.				Larned
Mz.				
Mo.				
V.				
S.				
S.				
A.				
R.				
Pe.				
G.				
T.D.				

FIRST REPORT
MAY 16 '56

Date Comm. 5-9-56
8" @ 982/500 drlg. 2740

County Panney Elev. 1997
 Sec. 4 Twp. 22 Rge. 16W
 Company A. F. Brann
 Farm Name Baxter No. 1

TOPS	DEPTH	LOG	DATUM	Loc. in Sec.
Anh.				SW NE SW
TP.				1739' SL
H.	3395			1710' WL
Tr.				Geol. <u>Allen</u>
Dg.	3501			Contr.
BL.	3509			<u>Musgrove</u>
L.				Pool
K.C.				<u>Larned</u>
B.K.C.				
Ce.				
C.				
M.				
M.				
K.				
Mz.				
Me.				
V.	3838			
S.				
S.	3848			
A.				
R.				
PE.				
G.				
TD.	3868			

ABANDONED

Date Comm. 5-9-56 MAY 23 1956

8" @ 982/500 drlg. 2740 MAY 23 '56

DST 3849-53 20" rec 20' Md

BHP 1360/15" DST 3850-68 1hr

rec 1980' solp wto + 360' solp

wto BHP 1200/20"

DEA