

Pawnee


KANSAS

SECTION 4 TOWNSHIP 22 RANGE 16W

WELL NO. #1 Buster-State

COMPANY Brann Oil Co.

NORTH

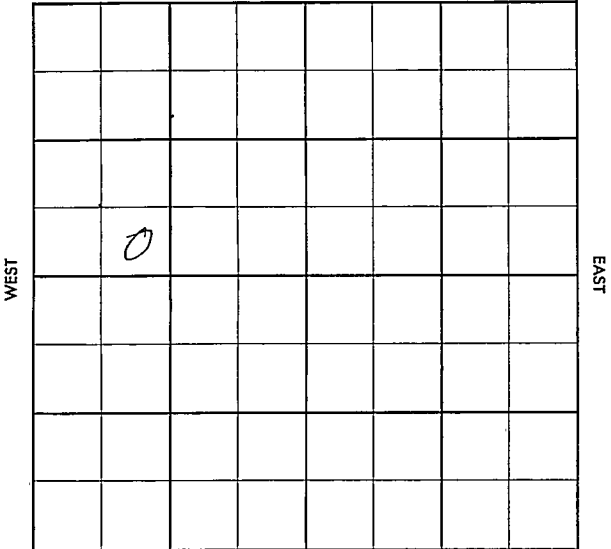

SOUTH

County Paynee Elev. _____
 Sec. 14 Twp. 22S Rgs. 16W
 Company Brann Oil Co.
 Farm Name Buster-State No. 1

TOPS	DEPTH	LOG	DATUM
Anh.	975		
TP.			
H.			
Tr.			
Dg.			
Bl.			
L.			
K.C.			
B.K.C.			
Ce.			
C.			
M.			
M.			
K.			
Mz.			
Me.			
V.			
S.			
S.			
A.			
R.			
PE.			
G.			
T.D.			


Loc. in Sec. _____
SE SW NW
1010' FWL x
2806' FSL
of Sec.
 Geol. _____
 Contr. _____
Musgrove Pet
 Pool _____
Larned SW

FIRST REPORT
 OCT 3 1956

Date Comm. 9-28-56
8" 980 w/500; D 1995

SEE 3 1 TOO

SEE 3 1 TOO

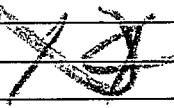

Co.
 Lst
 No.
 Sec.
 T.
 R.

AS. 11. 1956

County Parmer Elev. 1999
 Sec. 4 Twp. 22S Rge. 16W
 Company Branch Oil Co.
 Farm Name Buster-State No. 1

TOPS	DEPTH	LOG	DATUM	Loc. in Sec.
Anh.	975			SE SW NW
TP.				
H.	3397			1010' FWL X
Tr.				2806' FSL
Dg.				of Sec.
Bl.	3503			
L.	3510			Don Allen
K.C.				Geol.
B.K.C.				
Ce.				Contr.
C.				Musgrave Felt
M.				
M.				Pool
K.				Larned SW
Mz.				
Ma.				
V.				
S.				
S.				
A.	3844			
R.				
PE.				
G.				
TD.	3890.8			

NOV 15 '56
 COMPLETE

Date Comm. 9-28-56
8" 980 w/500; D 1995 OCT 10 '56 3682
OCT 17 '56 Tops DST 3840-52 of 1 hr run
3700' oil + 120' wtd. FP 240-1100
BHP 1120 RTD? 3894 R119 pipe
no log OCT 24 '56 5 1/2 @ 3894 WOCT
OCT 31 '56 PF, Anh. 10 Boph + wtd
OCT 7 '56 X PF 16/3842-48 12
Boph + Tr. wtd 6 hrs 1000' o.B (nat)
Pop. st tst today NOV 13 '56 120 BOPD
69% wtd 24 hrs. 9 am 47°