

Pawnee


DX 78-1

**KANSAS**

Section 4 Township 22 Range 16W

Well No. #1 Hanshew

Company Rocket Drlg.

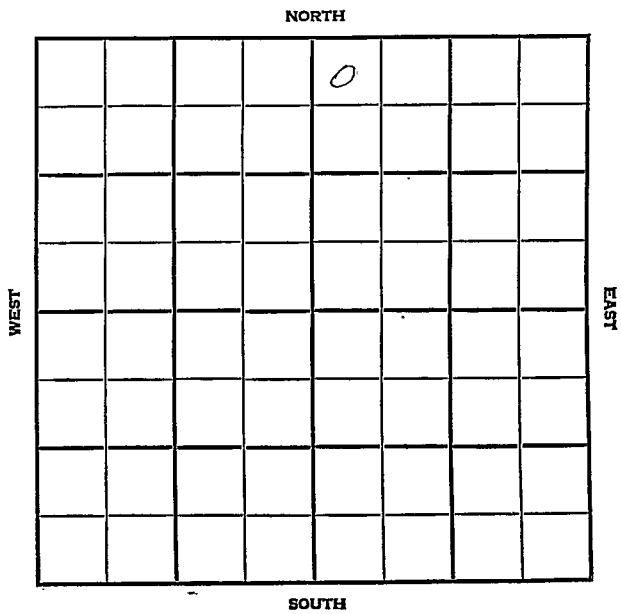



County Pawnee Elev. \_\_\_\_\_  
 Sec. 4 Twp. 22 Rgs. 16W  
 Company Rocket Drig.  
 Farm Name Hanshaw No. 1

TOPS	DEPTH	LOG	DATUM	Loc. in Sec.
Anh.				NW NW NE
TP.				
H.				
Tr.				
Dg.				
Bl.				
L.				Geol. _____
K.C.				Contr. _____
B.K.C.				
Ce.				
C.				
M.				
M.				Pool
K.				Larned
Mz.				
Me.				
V.				
S.				
S.				
A.				
R.				
PE.				FIRST REPORT
G.				MAY 23 '56
T.D.				

Date Comm. \_\_\_\_\_  
 Location \_\_\_\_\_

2281 S 2 1956

R. G.

Co.

Sec.

No.

Sec.

T.

R.

County Patnee Elev. 1994 DF  
 Sec. 4 Twp. 22 Rge. 16W  
 Company Rocket Drle.  
 Farm Name Manshew No. 1

TOPS	DEPTH	LOG	DATUM	Loc. in Sec.
Anh.	1977			NW NW NE
Tp.				
H.	3203			
Tr.				
Dg.				
Bl.	3802			
L.	3511			
K.C.				Geol.
B.K.C.				Contr.
Ce.				
C.				
M.				
M.				
K.				Pool
Mz.				Larned
Mo.				
V.				
S.				
S.				
A.	3850			
R.				
PC.				ABANDONED
G.				
T.D.	4119			

Date Comm. JUN 20 1956

Location MAY 29 '56 5-23-56 8 5/8

983/425 17 3335 JUN 1 '56

DST 3803 - 52 (30) rec 30' M

BHP 0(20) DST 3805 - 54 (60)

1350 GIP rec 85' M 50' Freq 0+

6CM BHP 0 DST 3852 - 56 (60)

rec 70' V50CM FFP 2060 BHP 0(60)

DST 3856 - 66 (90) 100' 6CM SSC

240' SW F.P. 125 BHP 200(20)

RTO 4119 5 1/2" 3835/490 SK SWDWR

JUN 13 '56

DD 4227

JUN 20 '56

DD 4286 TD 112 PST

240 BW 30"

comp. SWP Well