

Section 4 Township 22 Range 16W

Well No. #1 Hanshew

Company Gulf Oil

NORTH

							0

WEST

EAST

SOUTH

Pawnee

KANSAS

SEC. 4	TWP. 22	R. 16W ✓
-----------	------------	-------------

WELL NO.

1 Hanshew

FARM

COMPANY

Gulf Oil

CONTRACTOR

Barbour

Larned Pool


330 Ft. from N. Line

Ft. from S. Line

330 Ft. from E. Line

Ft. from W. Line

NE NE NE

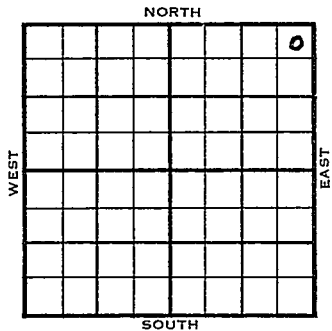

1953

ELEVATION

1992'

REPORT

9/30

Spud 9-24-53
 13" @ 115'
 Anhy 983'
 8" @ 988'
 Drlg. 1595'

10/7

Heeb 3397, Tor 3417, Br. L. 3503,
 Lans 3515, Cong 3821, Simp 3829, Arb
 3856
 RTD 3858
 5" @ 3858'

10/14

CO 3858 dry DD 3860 FU 400' oil 1 hr
 S/ 49-2/3 BO 4 hrs. 300A S/ 47 bo
 4 hrs.

10/21

DD 3863 S/ 43 bo / trace 12hrs.

10/28

N.R.

11/11

Spud 9-24-53 Oil well TD 3863
 13" @ 115 Anhy 983 8" @ 988
 Heeb 3397 Tor. 3417 Br line 3503
 Lans 3515 Cong 3821 Simp 3829
 Arb. 3856 TD 3858 5" @ 3857
 CO to 3858 dry DD 3860 FU 400'
 oil 1 hr. S/49 BO 4 hr. 300 A
 S/47 BO 4 hr. DD 3863 S/43 BO 12 hr.
 Comp. 50 BOPD 17 BW

DX-78

COMPLETED

