


Section 4 Township 22 Range 16 W

Well No. # 2 Hanshew

Company Gulf Oil

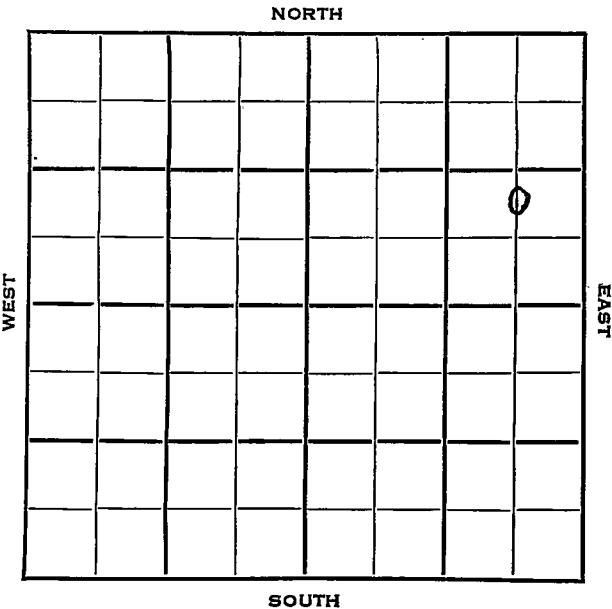

Pawnee

KANSAS

SEC.	TWP.	R.
4	22	16W ✓

WELL NO.

2 Hanshew

FARM

COMPANY

Gulf Oil

CONTRACTOR

Barbour

Larned Pool

1620

Ft. from N. Line


Ft. from S. Line

565

Ft. from E. Line

Ft. from W. Line

C N L S E N E

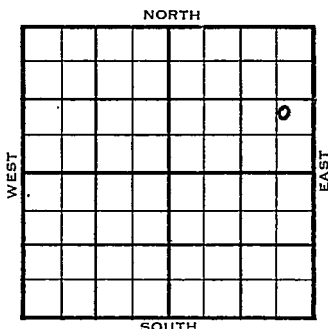

1953

ELEVATION

1993'

REPORT

10/21 Spud 10-17-53

Anhy 983'

10/28 10" @ 980'

Drlg 2833'

11/4 Heeb 3389', Tor 3410', Br. L. 3496,
Lans 3504'

11/11 DD 3851'

TD

S/ 208 BO 4 hrs.

12/16 Spud 10-17-53

Oil Well

TD 3851'

Anhy 983'

10" @ 980'

Heeb 3389', Tor 3410', Br lime 3496',
Lans 3504', Arb. 3847'

TD 3849'

7" @ 3848'


DD 3851, S/208 bo

Cong 3814'


Comp. 146 bopd 50% wtr.

COMPLETED

Kansas

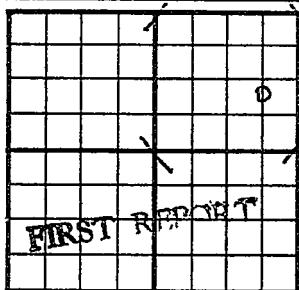County Pawnee State Sec. 4 (Blk.) 22 (Sur.) 16W Map No. Operator Gulf OilWell No. 2 Farm HanshawElev. Location C N I. SE NE1620 Ft. From N Line NE565 Ft. From E Line Quarter1st. Report OCT 21 1953Completion Remarks Barbour - Contr.Spudding Date 10-17-53Drilg. Data Larned PoolAnhy 983

J. G. McGEHEE

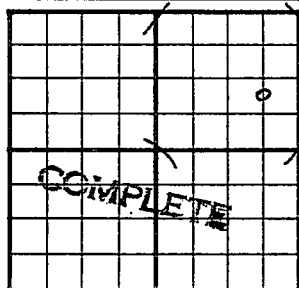County Pawnee State KansasSec. 4 (Blk. Twp.) 22 (Sur. Rge.) 16W Map No.Operator Gulf OilWell No. 2 Farm HanshewElev. 1993 Location C N L SE NE1620 Ft. From N Line NE565 Ft. From E Line Quarter

1st. Report

Completion DEC 16 1953Remarks Larned PoolBarbour - Contr.Spudding Date 10-17-53Drilg. Data Oil well TD 3851Anhy 983 10" @ 980 Heeb. 3389Tor. 3410 Br. lime 3496 Lans. 3504Arb. 3847 TD 3849 7" @ 3848 DD 3851S/ 208 bo Cong. 3814 Comp. 146 bopd50% wtr.

J. G. McGEHEE