

Section 4 Township 22 Range 16 WWell No. # 3 HanshewCompany Gulf Oil

						0	

NORTH

WEST

EAST

SOUTH

Pawnee KANSAS

SEC.	TWP.	R.
4	22	16W ✓

WELL NO.

3 Hanshew

FARM

COMPANY

Gulf Oil

CONTRACTOR

Barbour

Larned Pool


990 Ft. from N. Line

Ft. from S. Line

990 Ft. from E. Line

Ft. from W. Line

SW NE NE

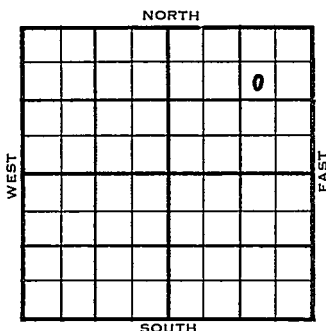

1953	ELEVATION	REPORT
	1993'	

11/18 Location

12/2 Spud 11-17-53 D & A TD 3955
 Anhy 981' 8" @ 985 Heeb 3408'
 Tor. 3427' Br. lime 3515' Lans
 3523' Cong. 3834' Simp. 3846'
 Arb. 3945'
 DST 3948-55 open 1 hr rec 150' muddy
 SW 1150#
 D & A

ABANDONED

County Pawnee State Kansas

Sec. 4 (Blk.) 22 (Sur.) 16W Map No.

Operator Gulf Oil

Well No. 3 Farm Hanshew

Elev.	1993	Location	SW NE NE
-------	------	----------	----------

ABANDONED

990 Ft. From N Line NE

990 Ft. From F. Line Quarter

1st. Report

Completion DEC 2 1957

Remarks	Larned Pool
---------	-------------

Barbour - Contr.

Spudding Date 11-17-53

Drlg. Data D & A TD 3955

Anhy 981 8" @-985 Heeb. 3408

Tor. 3427 Br. lime 3515 Lans. 3523

Cong. 3834 Simp. 3846 Arb. 3945

DST 3948-55 open 1 hr. Rec. 150' muddy

SW 1150[#]

D & A