


Pawnee

KANSAS

SECTION 4 TOWNSHIP 22 RANGE 16W

WELL NO. #1 Keast

COMPANY Rocket Drlg

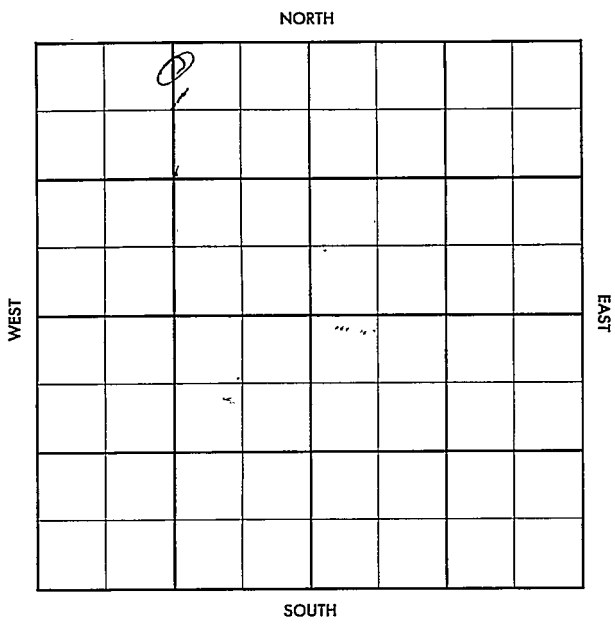

SEC. 4	TWP. 22	R. 16W
-----------	------------	-----------

WELL NO.

#1 Keast

FARM

COMPANY

Rocket Drlg.

CONTRACTOR

Co. Tools


Larned

Ft. from N. Line

Ft. from S. Line

Ft. from E. Line

Ft. from W. Line

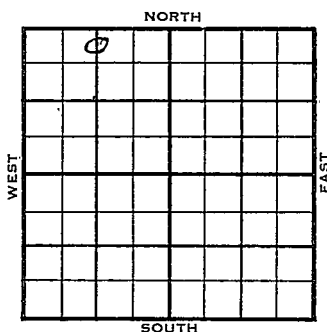C N $\frac{1}{2}$ N $\frac{1}{2}$ NW

1956

ELEVATION

1997 DF 1999 RB REPORT

4-11

Comm. 4-9-56

8" @ 979 w/400

WOC

Anh. 973

6-13

5 $\frac{1}{2}$ " @ 3839 $\frac{1}{2}$ w/120

CO DD 3841' tst

5. 1100 MCF DD 3844'

No inc. DD 3847 $\frac{1}{2}$ F/W est

7-to 8 Mill CFG / 10 boph 5.1

Pump 335 bopd / 33% wtr.

H. 3396', B.L. 3479', L. 3506',

B.K.C. 3751', C. 3815', S. 3834',

A. 3839',

TD 3840'

COMPLETED

County Pawnee Elev. _____
 Sec. 11 Twp. 22 Rgs. 16W
 Company Bucket Drlg.
 FarmName Keast No. 1

TOPS	DEPTH	LOG	DATUM
Anh.	973		
Tr.			
H.			
Tr.			
Dg.			
Bl.			
L.			
K.C.			
B.K.C.			
Ce.			
C.			
M.			
M.			
K.			
Mz.			
Ma.			
V.			
S.			
S.			
A			
R.			
PE.			
G.			
TD.			

Loc. in Sec. C N $\frac{1}{2}$ N $\frac{1}{2}$ NW

Geol. _____

Contr. Co. tools

Pool Larned

O		
FIRST REPORT		
APR 1 1955		

Date Comm. 11-9-56
 8" @ 979/400 WOC

APR 1 1955

R. G.

Co.
Lse.
No.
Sec.
T.
R.

1999 RB
 Sec. 11 Twp. 22 Rge. 16W
 Company Rocket Drllg.
 Farm Name Keast No. 1

Co.

TOPS	DEPTH	LOG	DATUM	Loc. in Sec.
Anh.	773			C N $\frac{1}{2}$ N $\frac{1}{2}$ NW
Tr.				
H.	3396			
Tr.				
Dg.				
BL.	3497			
L.	3506			
K.C.				Geol.
B.K.C.	3751			Contr.
Ce.				
C.	3815			In. tools
M.				
M.				Pool
K.				
Nz.				Landed
Mo.				
V.				
S.	3834			
S.				
A.	3839		-1850	COMPLETE
R.				
PE.				
G.				
TD.	3840			JUN 13 '56

Lse.

No.

Sec.

T.

R.

Date Comm. 11-2-'66
8" @ 979/300 109 APR 18 '56 DD 3820
APR 25 '56 5 1/2 @ 3839 1/2 / 120 CO DD
3841 test 5.100 MCF DD 3844
no inc DD 3847 1/2 Flw est
7 TO 8 Mill CFG + 10 Boph. S.I
MAY 2 '56 MAY 9 '56 MAY 15 '56 ✓ MAY 23 '56 MAY 29 '56
JUN 6 '56 JUN 13 '56 Qty 335 BODD T 3270
etc. arb apex line 3839-47 1/2