


Pawnee

KANSAS

SECTION 4 TOWNSHIP 22 RANGE 16W

WELL NO. #1 Mattnee-Dodge Unit

COMPANY A.F. Brann

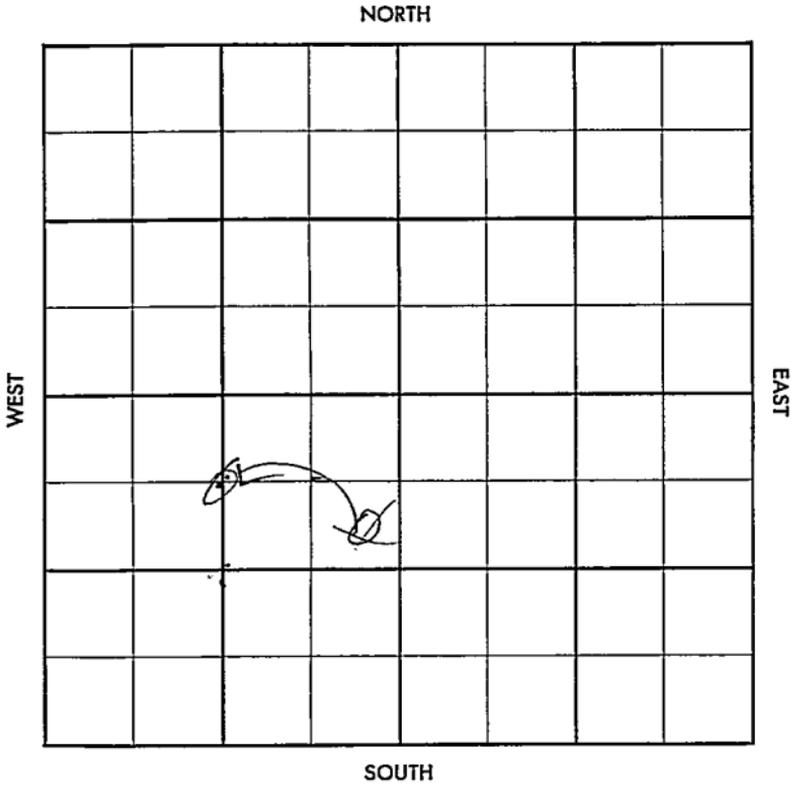

SEC. 4	TWP. 22	R. 16W
-----------	------------	-----------

WELL NO.

#1 Mattnee-Dodge Unit

FARM

COMPANY

A.F. Brann

CONTRACTOR

Musgrove


Larned

_____ Ft. from N. Line

_____ Ft. from S. Line

_____ Ft. from E. Line

_____ Ft. from W. Line

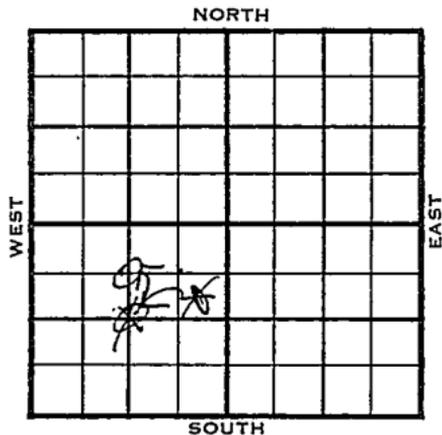

~~SE NE SW~~ *e N/2 SW*

1956	ELEVATION	REPORT
	1998'	

4-4 Comm. 4-2-56
8" @ 981
Orlg. 1400

5-2 5 1/2" @ 3893
CO 16/ 3838-42, 50 gal acid
S/ 13 BO, in 1 hr. no/wtr.
P/ 6 BOPH, ~~###~~ no wtr.
P/ 186 BOPD, no/wtr.
Grav. 48
H. 3396
BL. 3500
L. 3508
BKC 3728
S. 3829
A. 3828- 3839
TD 3894'

COMPLETED

County Paynee Elev. _____
 Sec. 4 Twp. 22 Rgs. 16W
 Company A. F. Brann
 FarmName Mattnee-Dodge Unit No. 1

TOPS	DEPTH	LOG	DATUM
Anh.			
TP.			
H.			
Tr.			
Dg.			
Bl.			
L.			
K.C.			
B.K.C.			
Ce.			
C.			
M.			
M.			
K.			
Mz.			
Mo.			
V.			
S.			
S.			
A.			
R.			
PE.			
G.			
T.B.			

Loc. in Sec. SE NE SW

Geol. _____

Contr. Musgrove


Pool Larned

PIT REPORT 0 APR 4 '56		

Date Comm. 4-2-56
8" @ 981 drlg. 1400

APR 1 1956

R. C.

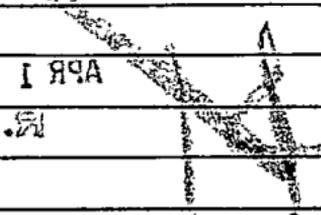

Co.
Lse.
No.
Sec.
T.
R.

CORRECTION

FORM 513 SUNRAY

County Pawnee Elev. 1998
 Sec. 4 Twp. 22 Rge. 16W
 Company A. F. Brann
 Farm Name Mattnee-Dodge Unit No. 1

TOPS	DEPTH	LOG	DATUM
Anh.			
Ip.			
H.		3396	
Tr.			
Dg.			
BL		3500	1502
L.		3508	1510
K.C.			
B.K.C.		3728	1730
Ce.			
C.			
M.			
M.			
K.			
Mz.			
Mo.			
V.			
S.		3829	1831
S.			
A	3828	3828	3839 1841
R.			
PE.			
G.			
TD	3894		

Loc. in Sec. SW
C N/2

Geol. _____
 Contr. _____
Musgrove
 Pool _____
Larned

COMPLETE	
o	x

Date Comm. 1-2-56 MAY 2 1956

8" @ 981 APR 11 '56 3830

APR 15 '56 5 1/2 @ 3893 APR 25 '56 CO 161

3838-42 50 gal acid @ 13 B0
in 1 hr no/w P. 6 Bopk no/w
w/o POT. MAY 2 '55 Ph P. 186 Bopd
no/w gran 48°