

DX 78-1


Pawnee

KANSAS

Section 4 Township 22 Range 16W

Well No. #3 Mattnee-Dodge Unit

Company Brann Oil Co.

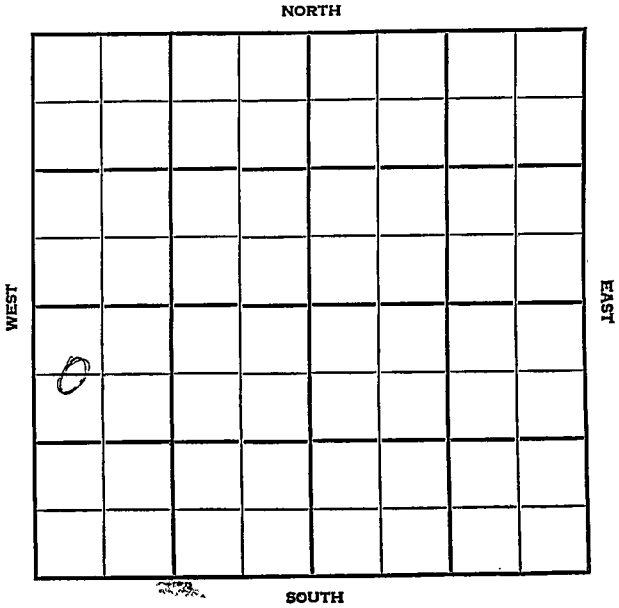

County Pawnee Elev. \_\_\_\_\_  
 Sec. 4 Twp. 22 Rge. 16W  
 Company Brann Oil Co.  
 FarmName Mattnee-Dodge Unit No. 3

TOPS	DEPTH	LOG	DATUM
Anh.			
Tp.			
H.			
Tr.			
Dg.			
Bl.			
L.			
K.C.			
B.K.C.			
Ce.			
C.			
M.			
M.			
K.			
Mz.			
Mo.			
V.			
S.			
S.			
A.			
R.			
PE.			
G.			
TR.			

Loc. in Sec. \_\_\_\_\_  
C W/2 NW SW  
1968' fsl x 330'  
fwl SW/4  
 Geol. \_\_\_\_\_  
 Contr. \_\_\_\_\_  
Musgrove Tools  
 Pool \_\_\_\_\_  
Larried SW

FIRST REPORT	
OCT 17 '55	
0	

Date Comm. BURT

2801 1 5 500

*[Handwritten scribbles and marks]*

Co.  
L.S.  
No.  
Sec.  
T.  
R.

County	Paynee	Elev.	2003 RB
Sec.	4	Twp.	22
Company	Brank Oil Co.	Rgs.	16W 1999 DF
Farm Name	Mattnee-Dodge Unit	No.	3

TOPS	DEPTH	LOG	DATUM	Loc. in Sec.
Anh.	970			C W/2 NW SW
Tr.				1968' fsl x 330'
H.	3398			
Dg.				fwi SW/4
RI.	3502			
L.	3511			Geol.
K.C.				Contr.
B.K.C.				Musgrove Tools
Ce.				Pool
C.				Larned SW
M.				
M.				
K.				
Mz.				
Me.				
V.				
S.				
S.				
A	3842			COMPLETE
R.				
PE				
G.				NOV 5 '56
T.D.	3892			

Date Comm.

BURT	OCT 24 '56	10 - 12 - 56
8 5/8	981 / 500	5 1/2 @ 3892
OCT 31 '56	PF Ark	\$ 5 Bopd +
wt.	OCT 7 '56	X PF 16 / 3842-46
100 gal acid	\$ 9 Bopd	nd/w
6 hrs Pop	st + st today	NOV 13 '56
Ph P	90 Bopd +	68% wt
graw	47.4°	