

Pawnee

KANSAS
16W

4

22S


SECTION _____ TOWNSHIP _____ RANGE _____

WELL NO. #1 Nauret Simmons

COMPANY Rocket Drlg.

NORTH

S/2 NW SE

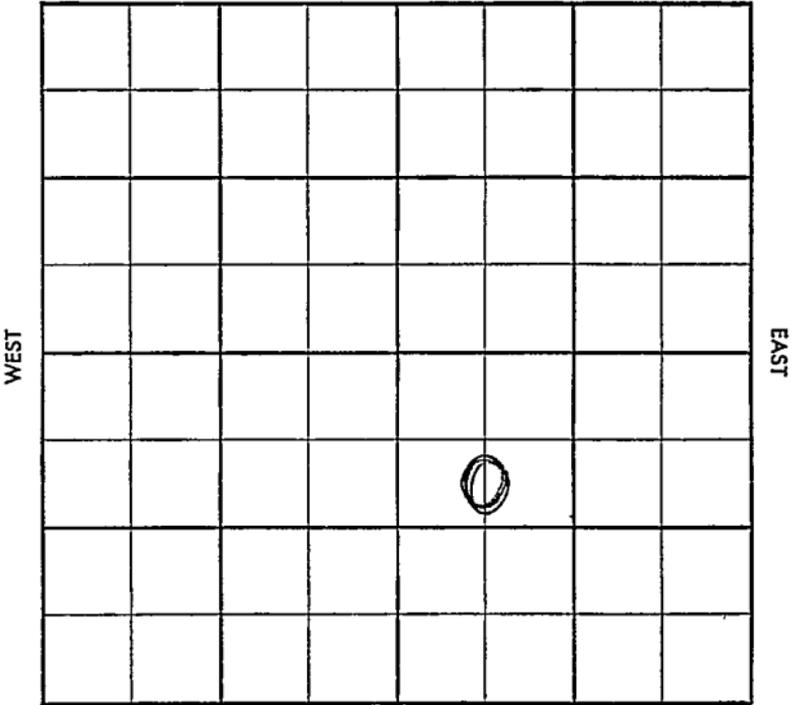

SOUTH

S-513-A

CO. Pawnee ELEV. _____
SEC. 4 TWP. 22 RGE. 16W
COMPANY Rocket Drlg. NO. 1

ABANDONED

OCT 30 57

FARM Mauret Simons

LOC. S/2 NW SE

Ashy 981

Hb 3406

B1 3512

L 3521

A 3863

TD 3870

GEOL. _____

CONTR. Akin Drlg.

POOL Larned

SPUD 10-13-57

3" - 790 Drlg. 2030

DST 3064-70

60" 2370' sup LV

EMPI 125/20

ran log

D & A

CO.

USE

NO.

SEC.

TWP.

RGE.