


Section 4 Township 22 Range 7-W

Well No. 1 Paine (Peine)

Company Pulse et al

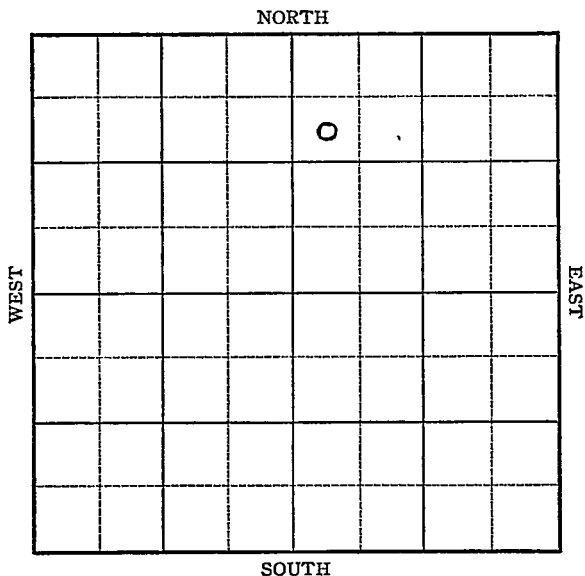

O. W. D. D

Map No. KANSAS Sec. 4 Twp. 22 R. 7W

Well No. #1 Peine Farm

Pulse et al Company

990' Ft. from N. Line


_____ Ft. from S. Line

_____ Ft. from E. Line

330'

_____ Ft. from W. Line

Elev. 1603

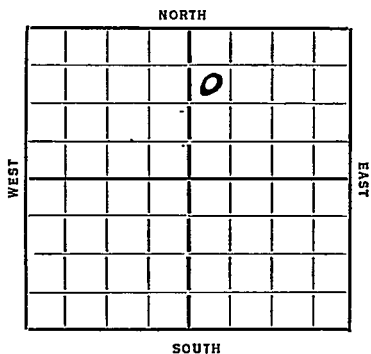

Date 1936 REPORT O. W. D. D.

8/12 Rig on ground.

8/20 -- 8/27 -- 9/3 -- 9/10 -- 9/18 -- 9/26 --

10/1 --

10/8 Rigging up.

10/15 15" @ 71'. Waiting on cement.

10/22 12" @ 133'. Drlg. 385'

10/29 Drlg. 1175'.

11/6 Drlg. 1800

11/12 Run 10" @ 1905

11/19 Drlg. 1940'.

11/27 Shut down 1940'.

12/3 ---

12/10 10" @ 1900'. T. D. 1955'.
Shut down.

12/17 " " 12/24 --- 12/29 --

1937

1/7 Drlg. 2500'.

1/14 Shut down 2680'.

1/21 Toneyka 2320'. 8" @ 2700'.
Drlg. 2715'.

1/28 2895' underream 8".

OVER

1937

2/4 8" @ 2895'. C.O.

2/11 8" @ 2920 Drlg. 2955'

2/18 KCL 2907'. Drlg. 3100'.

2/26 Shut Down 3100'.

3/4 6" @ 3230' Drlg. 3342'.

3/11 Conglomerate 3405', Chat 3415'
Water 3432-40 TD plug back 3416'.

3/18 Plug back 3244' - 500' oil in
hole

3/25 " " "

4/2 Pump 10 bbls per-hr.

4/8 Shut Down.

4/16 " "

4/23 " "

4/30 Shot W/40 qts. 3244-62'.
Fishing.

5/7 " " " "

5/14 " " " "

5/21 6" @ 3243'. WOC.

5/28 " " "

6/4 T.D. 3287'. Pulling 8".

OVER

1937

6/9 6" @ 3243'.
K.C. 2907'.
Cong. 3405'.
Chat 3415'.
T.D. 3440'.
P.B. 3287'.
1000 Acid.
2000 acid.
Shot 40 qts. 3244-62'.
Pot. 156 bbls.

COMPLETED

1938

O. W. D. D.

1/19 Old T.D. 3440'.
P.B. to 3287'.
Will deepen to Arb. Line.
1/28 " " " " "
2/4 5" - 3440' Base Miss. 3545'
Drlg. 3630'
2/11 Drlg. 3785'.
2/16 5" @ 3440'.
Arb. 3863'.
T.D. 3880'.
H.F.W.

ABANDONED

ABANDONED

Map No. 49 Sec. 4 Twp. 22 R. 7WWell No. 1 PeinoPeino & Co Company

Contractor

SECTION PLAT

		0	

990 Ft. from N. Line

_____ Ft. from S. Line

_____ Ft. from E. Line

320 Ft. from W. Line

FIRST REPORT

Location _____

Rig up _____

Drilling and Remarks:

ROY

RECORD

Cased _____ in., _____ ft.

Sand _____

Gas _____

Oil _____

Total Depth _____

PRODUCTION

1st 24 hrs. Nat. _____

1st 24 hrs. after shot _____

Gas _____ Cu. Ft.

Dry Hole _____

Abandoned _____

Date

AUG 12 1936

19

S. J. LEWIS Scout

Map No. 49 Sec. 4 Twp. 22 R. 7 W

Well No. 1 - Peine

Pulse etal Company

Contractor

COMPLETED

990 Ft. from N. Line

_____ Ft. from S. Line

1 Ft. from E. Line

330 Ft. from W. Line

SECTION PLAT

		0	

Location _____

Rig up _____

Drilling and Remarks:

P.B. 3287 - 1000 Acid
2000 Acid

shot w/40gts
3244-62

Pat - 156

RECORD

Cased 6 in., 3243 ft.

Sand K.C - 2907

Gas CO19-3403

Oil C178T-3415

Total Depth 3440

PRODUCTION

1st 24 hrs. Nat. _____

1st 24 hrs. after shot _____

Gas _____ Cu. Ft.

Dry Hole _____

Abandoned _____

Date

JUN 9 1937

H. D. Hatfield

Scout

Reno

KANSASMap No. 49 Sec. 4 Twp. 22 R. 7WWell No. 1 Paine (Peine)Pulse etal

Company

Contractor

FIRST REPORT

SW NW NE

990 Ft. from N. Line

_____ Ft. from S. Line

_____ Ft. from E. Line

330 Ft. from W. Line**SECTION PLAT**

		0	

Location _____

Rig up _____

Drilling and Remarks:
OWDD OTD. 3440

P.B. 3287

Will deepen to
Arb. Lime**RECORD**

Cased _____ in., _____ ft.

Sand _____

Gas _____

Oil _____

Total Depth _____

PRODUCTION

1st 24 hrs. Nat. _____

1st 24 hrs. after shot. _____

Gas _____ Cu. Ft.

Dry Hole _____

Abandoned _____

Date

JAN 19 1938 19

H. D. Hatfield Scout

KANSAS

Reno

Map No. _____ Sec. 4 Twp. 22 R. 7WWell No. 1 PainePulse etal Company

Contractor

ABANDONED
SW NW NE990 Ft. from N. Line

_____ Ft. from S. Line

_____ Ft. from E. Line

330 Ft. from W. Line

SECTION PLAT

		0	

OWDD

Location _____

Rig up _____

Drilling and Remarks:

HFW

DVA

RECORD

Cased 5 in., 3440 ft.Sand Ab 3863

Gas _____

Oil _____

Total Depth 3880

PRODUCTION

1st 24 hrs. Nat. _____

1st 24 hrs. after shot _____

Gas _____ Cu. Ft.

Dry Hole _____

Abandoned _____

Date

FEB 16 1938

19

H. D. Hatfield Scout