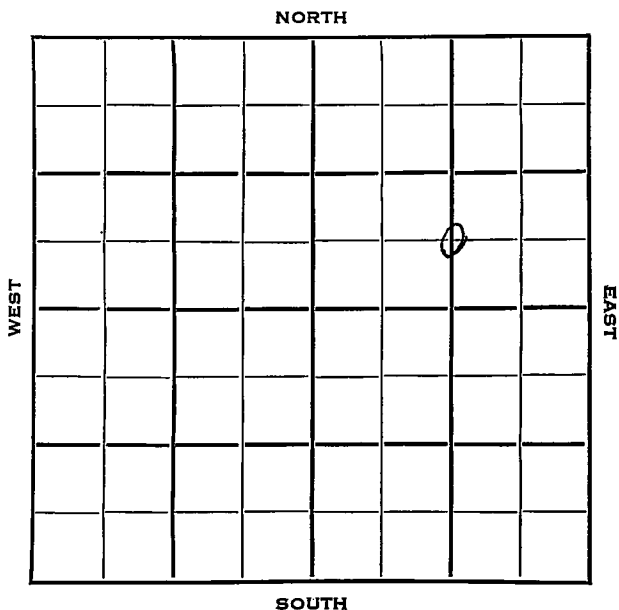


Section 4 Township 22 Range 8 WWell No. # 1 Farrell-MeyerCompany Tom Allen et al

Rice		KANSAS
SEC.	TWP.	R.
4	22	8W ✓
WELL NO.		
#1 Farrell - Meyer		FARM
COMPANY		
Tom Allen et al		
CONTRACTOR		
Tom Allen		


_____ Ft. from N. Line

660 _____ Ft. from S. Line

1320 _____ Ft. from E. Line

_____ Ft. from W. Line


C S $\frac{1}{2}$ NE

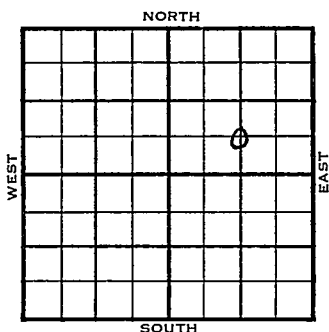

	ELEVATION	REPORT
1953	1634'	
12/22	R U R	
1954 1/6	8" @ 199'	Br li 2947', L ans 2975', Cong 3355' Miss 3362' RTD 3365' 5" @ 3365'
1/13	DD 3379'	B/ 4 goph / 1 1/2 gwph 5 hrs. A-frac.
1/20	S/1 1/2 BOPH	Sd-O-frac. S/36 BO 24 hrs. POP
2/17	Spud 12-21-53 Oil Well TD 3379' 8" @ 199'	Br line 2947', L ans 2975', Cong 3355', Miss 3362' TD 3365' 5" @ 3365' DD 3379', B/4 goph 1 1/2 gwph, 5 hrs. A-frac, S/1 1/2 boph, sd-oil-frac S/36 bo 24 hrs. Comp. 9 bopd 2 bw

COMPLETED

County **Rice** State **Kansas**
 Sec. **4** (Blk.) **22** (Sur.) **8W** Map No.
 Operator **Tom Allen et al.**
 Well No. **1** Farm **Farrell - Meyer**
 Elev. Location **C S $\frac{1}{2}$ NE**

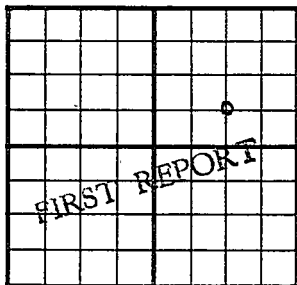


660 Ft. From **S** Line **NE**
1320 Ft. From **E** Line Quarter
 1st. Report **DEC 22 1953**
 Completion
 Remarks
Tom Allen - Contr.
 Spudding Date

Drlg. Data

R U R

J. G. McGEHEE

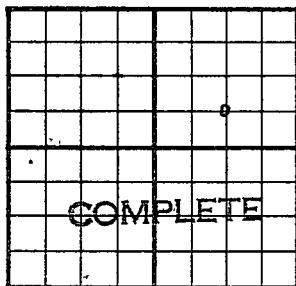County Rice State KansasSec. 4 (Blk. 22 (Sur. 8W Map No.)
(Twp.) (Rge.)Operator Tom Allen etal.Well No. 1 Farm Farrell - MeyerElev. 1634 Location C S $\frac{1}{2}$ NE660 Ft. From S Line NE1320 Ft. From E Line Quarter1st. ReportCompletion FEB 17 1954RemarksTom Allen - Contr.Spudding Date 12-21-53Drlg. Data Oil well TD 33798" @ 199 Br. lime 2947 Lans. 2975Cong. 3355 Miss. 3362 TD 33655" @ 3365 DD 3379 B/ 4 goph 1 $\frac{1}{2}$ gwph5 hr. A-frac S/ $\frac{1}{2}$ boph sd-oil-fracS/ 36 bo 24 hr. Comp. 9 bopd 2 bw

J. G. McGEHEE