


Section 4 Township 22 Range 8W

Well No. 1 Mayer

Company Tom Allen

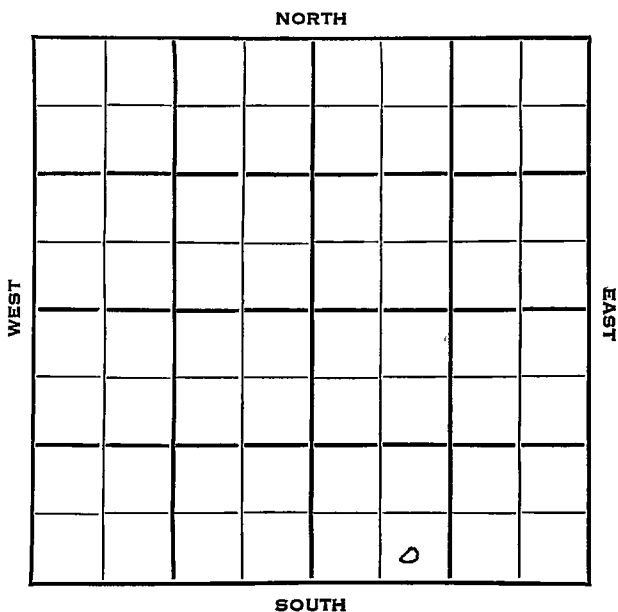

Rice

KANSAS ✓

Sec. 4 Twp. 22 R. 8W

Well No. L Mayer Farm

Tom Allen Company

Tom Allen Contr. Contractor


\_\_\_\_\_ Ft. from N. Line

330 Ft. from S. Line

\_\_\_\_\_ Ft. from E. Line

990 Ft. from W. Line

SE SW SE

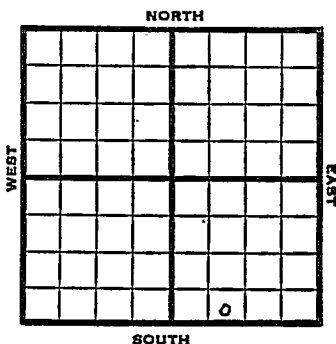

1953 Elev. 1659' REPORT

1/7 Spudding Date 1/3/53  
8" @ 233

1/22 Lans 3007, Cong 3383  
RTD 3385  
5" @ 3385

1/29 NR

2/5 Br li 2985  
CO 3385  
DD 3397  
S/30 goph  
sd-frac  
S/4 BOPH, POP

2/12 P/50 BOPD

2/19 P/35 BOPD

2/26 NR

3/12 "

3/18 "

3/26 "

4/2 "

**OVER**

1953

4/8

Spud 1-3-53

Oil well TD 3397' 8" @ 233

Lans. 3007' Miss. 3383 Br li 2985'

TD 3385 5" @ 3385 DD 3397

S/30 GOPH Sd-frac. S/4 BOPH

P/50 BOPD P/35 BOPD

Comp. 23 BOPD

**COMPLETED**



