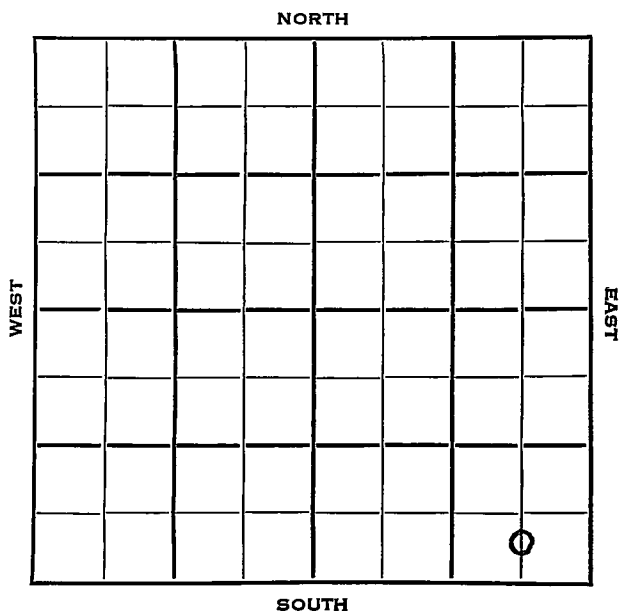


Section 4 Township 22 Range 8 WWell No. # 4 MayerCompany Tom Allan

Rice		KANSAS
SEC.	TWP.	R.
4	22	8 W ✓

WELL NO.

4 Mayer

FARM

COMPANY

Tom Allen

CONTRACTOR

Tom Allan

Sterling Pool


_____ Ft. from N. Line

330 _____ Ft. from S. Line

660 _____ Ft. from E. Line

_____ Ft. from W. Line

C S L SE SE

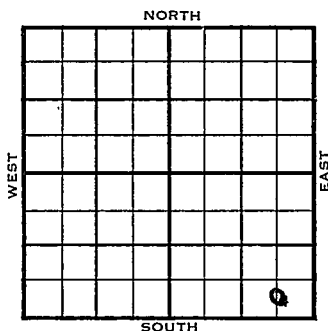


1953	ELEVATION	REPORT
	1661'	

10/14 MIR
 10/21 8" @ 202
 Drlg. 2479'
 10/28 Br. L. 2972', Lans 3000', Miss 3374,
 RTD 3395'
 5" @ 3395'
 11/4 DD 3435' TD
 PB 3411'
 S/33 goph
 Sd-o-frac
 11/11 Spud 10-14-53 Oil well TD 3435'
 8" @ 202 Br lime 2972 Lans 3000
 Miss 3374 TD 3395 5" @ 3395
 DD 3435 PB 3411 S/33 GOPH
 sd-oil-frac. Comp. 30 BOPD

COMPLETED

J. G. McGEHEE

County Rice State Kansas
 Sec. 4 (Blk.) 22 (Sur.) 8W Map No.
 Operator Tom Allan
 Well No. 4 Farm Mayer
 Elev. 1661 Location C S L SE SE

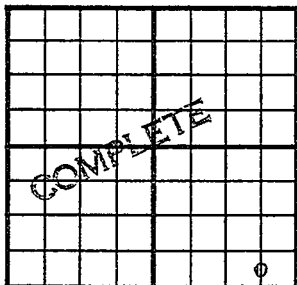

330Ft. From S Line SE
660Ft. From E Line Quarter

1st. Report

Completion NOV 11 1953

Remarks Sterling Pool

Tom Allan - Contr.

Spudding Date 10-14-53

Drlg. Data Oil well TD 3435

8" @ 202 Br. lime 2972 Lans. 3000

Miss. 3374 TD 3395 5" @ 3395

DD 3435 PB 3411 S/ 33 goph sd-oil-frac

Comp. 30 bopd

J. G. McGEHEE