

Stafford


FORM 51

KANSAS

Section 4 Township 22 Range 11W

Well No. #1 Fair "B"

Company Republic Natural Gas

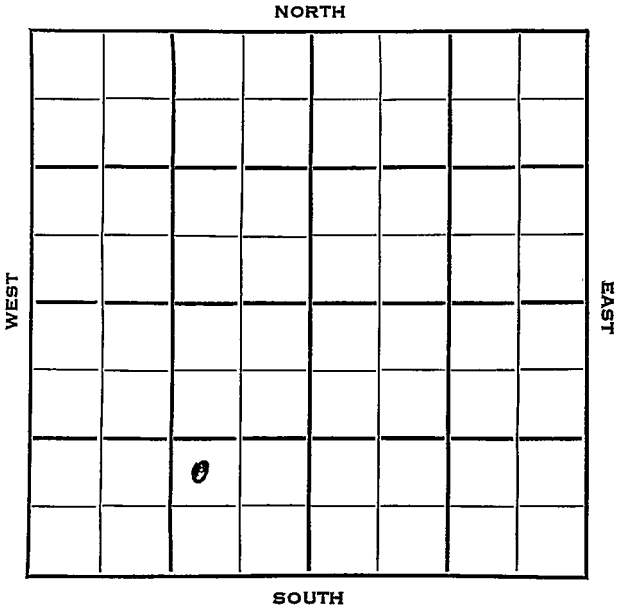

Stafford KANSAS


SEC. <div style="text-align: center; font-size: 2em;">4</div>	TWP. <div style="text-align: center; font-size: 2em;">22</div>	R. <div style="text-align: center; font-size: 2em;">11W</div> ✓
--	---	--

WELL NO. FARM
1 Fair "B"

COMPANY
Republic Natural Gas

CONTRACTOR
Gabbert-Jones
Wildcat

_____ Ft. from N. Line
990 _____ Ft. from S. Line
990 _____ Ft. from E. Line
 _____ Ft. from W. Line

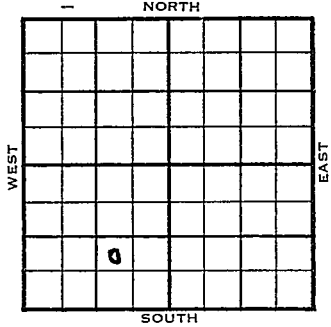

NW SE SW

	ELEVATION	REPORT
1954	1745'	
4/21		Spud 4-15-54 8" @ 300' Anhy 475' Drlg. 2138'
5/5		Heeb 2990', Br li 3124', Lans 3149' DST 3192-3229', 1 hr., F oil in 15", 840' gco, 180' MOCW, 1100# DST 3265-93', 1 hr., 65' gcm, 1050# DST 3296-3319', 1 hr., 1200' oil, 1180# DST 3319-38, 1/2 hrs., 40' M, 1100# Cong 3419' DST 3419-66', 1 hr., 660' oil, 1000# RTD 3584' Schl 5" @ 3583' Arb. 3520'
5/12		CO 3584' 30/3297-3302', 1000A S/25 BOPH 6 hrs., POP
5/19		P/ 10 BOPH 30 hrs.
5/26		Spud 4-15-54 Oil well TD 3584 8" @ 300 Anhy 475 Heeb 2990 Br. lime 3124 Lans 3149 DST 3192-3229 open 1 hr F/oil 15 min rec 840' GCO, 180' mud & OCW 1100#

OVER

1954
5/26

(Information continued)

DST 3265-93, open 1 hr rec 65' GCM
1050#

DST 3296-3319 open 1 hr rec 1200' oil
1180#

DST 3319-38, open $\frac{1}{2}$ hr rec 40' mud.
1100# Cong 3419' -

DST 3419-66 open 1 hr rec 660' oil
1000# TD 3584 5" @ 3583 Arb. 3520

CO to 3584 30/3297-3302 1000 A

S/25 BOPH 6 hr. P/10 BOPH 30 hr.

Comp. 338 BOPD 2% wtr.

COMPLETED

County **Stafford** State **Kansas**

Sec. **4** (Blk.) **22** (Sur.) **11W** Map No.

Operator **Republic Natural Gas**

Well No. **1** Farm **Fair "B"**

Elev. Location **NW SE SW**

990 Ft. From **S** Line **SW**

990 Ft. From **E** Line Quarter

Ist. Report **APR 21 1954**

Completion

Remarks

Gabbert-Jones - Contr.

Spudding Date **4-15-54**

Drlg. Data **Wildcat**

8" @ 300 Anhy 475 drlg. 2138

