

Section 4 Township 22 Range 12E

Well No. 1 Schrader

Company Aylward & Bishop

No Name

NORTH

| | | | | | | | |
|--|--|--|--|--|--|--|--|
| | | | | | | | |
| | | | | | | | |
WEST

EAST

SOUTH

KANSAS

Stafford

Sec. 4 Twp. 22 R. 12W

Well No. #1 Schrader Farm
Aylward & Bishop Company


No name

_____ Ft. from N. Line

330' Ft. from S. Line

_____ Ft. from E. Line

330' Ft. from W. Line

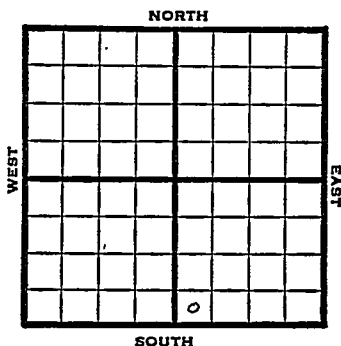

SW SE

1949 Elev. 1836' **REPORT**

- 1/19 Location
- 1/26 8"@ 298'
Drlg 1500'
- 2/2 Topeka 2898'
Lansing 3318'
Drlg 3444'
- 2/9 Viola 3557'
Simpson 3606'
Arbuckle 3665'
TD 3667'
5"@ 3665'
- 2/16 Arb. 3665'
TD 3682'

ABANDONED

Map No. _____ Sec. 4 Twp. 22 R. 12W

Well No. 1 Schrader

Aylward & Bishop Company

FIRST REPORT Contractor

SW SE


SECTION PLAT

_____ Ft. from N. Line

330 Ft. from S. Line

_____ Ft. from E. Line

330 Ft. from W. Line

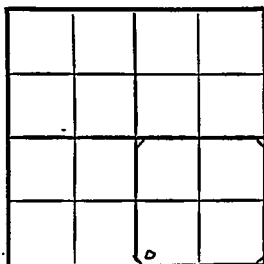

Stafford County

RECORD

Location X

Cased _____ in., _____ ft.

Rig up _____

Sand _____

Drilling and Remarks:

Gas _____

Oil _____

Total Depth _____

PRODUCTION

1st 24 hrs. Nat. _____

1st 24 hrs. after shot _____

Gas _____ Cu. Ft.

Dry Hole _____

Abandoned _____

Date

JAN 1 9 1940 19

S. J. LEWIS Scout

Kansas

Map No. K46 Sec. 4 Twp. 22 R. 12WWell No. 1 SchraderAvlward & Bishop

Company

ABANDONED

Contractor

SW SE

E. 1966
SECTION PLAT Ft. from N. Line330 Ft. from S. Line Ft. from E. Line330 Ft. from W. Line

| | | | |
|--|--|--|--|
| | | | |
| | | | |
| | | | |
| | | | |

Stafford County

Location _____

Rig up _____

Drilling and Remarks:

CR 83665

RECORD

Cased _____ in., _____ ft.

Sand _____

Gas _____

Oil _____

Total Depth 3680

PRODUCTION

1st 24 hrs. Nat. _____

1st 24 hrs. after shot _____

Gas _____ Cu. Ft.

Dry Hole _____

Abandoned _____

Date

FEB 16 1949 19S. J. LEWIS

Scout