


Company Phillips
Sittner Pool

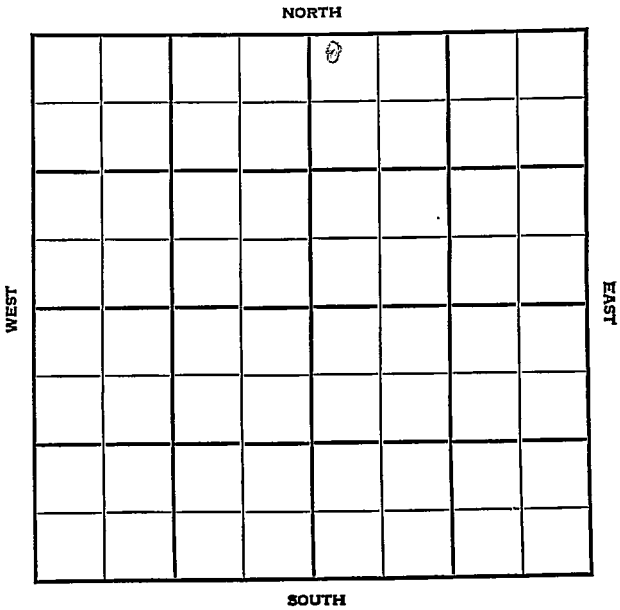

KANSAS

Stafford



Sec. 4 Twp. 22 R. 12W

Well No. #1 Fricke Farm

Phillips

Company

Sittner Pool

NORTH


330' Ft. from N. Line

Ft. from S. Line

330' Ft. from E. Line

Ft. from W. Line

NE NE

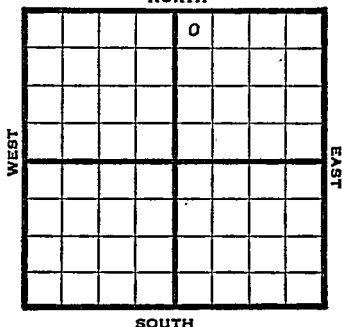

1948

Elev. 1868

REPORT

6/16

8" @ 459'
Drlg. 1690'

6/23

Drlg 3273'

6/30

Lans. 3311'
Viola 3584'
Simpson 3626'
Arbuckle 3602'
TD 3702'

ABANDONED

Map No. _____ Sec. 4 Twp. 22 R. 12W

Well No. 1 Fricke

Phillips Company

FIRST REPORT Contractor

NW NE


SECTION PLAT

330 Ft. from N. Line

_____ Ft. from S. Line

_____ Ft. from E. Line

330
_____ Ft. from W. Line

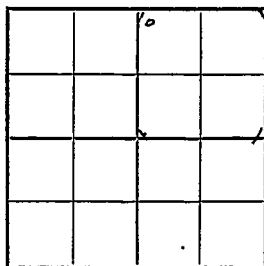

Stafford County

Location _____

Rig up _____

Drilling and Remarks:

8" @ 459

drlg. 1690

RECORD

Cased _____ in. _____ ft.

Sand _____

Gas _____

Oil _____

Total Depth _____

PRODUCTION

1st 24 hrs. Nat. _____

1st 24 hrs. after shot _____

Gas _____ Cu. Ft.

Dry Hole _____

Abandoned _____

Date

JUN 16 1948 19 _____ S. J. LEWIS Scout

Map No. 46 Sec. 4 Twp. 22 R. 12W

Well No. 1 Fricke

Phillips Company

ABANDONED

Contractor

NW NE

E.I. 1868

SECTION PLAT

		4	

330 Ft. from N. Line

 Ft. from S. Line

 Ft. from E. Line

330 Ft. from W. Line

Stafford County

Location

Rig up

Drilling and Remarks:

Loc 3311
10/23/54
Drill 3626
Art 3662

RECORD

Cased in., ft.

Sand

Gas

Oil

Total Depth 3702

PRODUCTION

1st 24 hrs. Nat.

1st 24 hrs. after shot

Gas Cu. Ft.

Dry Hole

Abandoned

Date

JUN 30 1948

19

S. J. LEWIS

Scout