


Section 4 Township 22 Range 12-W


Well No. 1 Sittner

Company Cardinal Oil et al

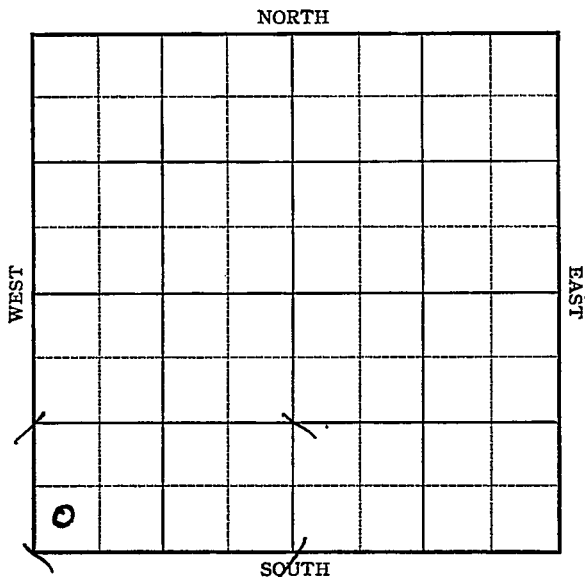

Sec. 4 Twp. 22 R. 12-WWell No. #1 Sittner FarmCardinal Oil et al Company Ft. from N. Line330 Ft. from S. Line Ft. from E. Line330 Ft. from W. Line

Elev. 1867

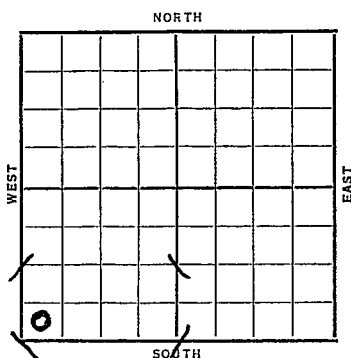

Date	REPORT
1937	
12/15	S. H.
12/24	12" @ 225'. WOC.
12/31	Anhy 660'? Drlg. 1831'.
1938	
1/7	Fort Riley 1672'. Drlg. 2920'.
1/10	Top Topeka 2960 Kansas City 3337 Dlg. 3341. No shows. (Tel)
1/14	Lans. 3337'. Sm. S.O. 3525-35'. Base K.C. 3555'. Cherty Viola 3583'. Drlg. 3610'.
1/20	Simp. 3630' Arb. 3686' T.D. 3696' Spotted sat. 7"- 3686' R.U.S.T.
1/28	T.D. 3696' Drilled plug 400' oil - 3 hrs 64 gal. Acid No inc. Grav. 32 5/69 Perforated 53 shots 3386-93 700' fluid - 2½ hrs.
2/4	2900 Acid. Deepened to T.D. 3700' Swb 5 hrs & 2 Wtr P.H.

OVER

1938

- 2/11 Shot 10 qts. 3694-98'.
Swab 11 oil & 7 wtr. in 8 hrs.
Set 24 hrs & swab 40 wtr. &
5 oil & 4 hrs.
- 2/18 5000 acid. Swab 7 oil & 20
water in 6 hrs.
- 2/26 Testing.

- 3/2 7" @ 3686'.
Arb. 3686'.
T.D. 3700'.
D & A

ABANDONED

Stafford **KANSAS**Map No. _____ Sec. 4 Twp. 22 R. 12WWell No. 1 Sittner_____ Cardinal Oil etal _____ Company

_____ Contractor

ABANDONED**SW/c**

_____ Ft. from N. Line

330 Ft. from S. Line

_____ Ft. from E. Line

330 Ft. from W. Line**SECTION PLAT**

0			

Location _____

Rig up _____

Drilling and Remarks:

*DVA***RECORD**Cased 7 in., 3686 ft.Sand 4-6 3686

Gas _____

Oil _____

Total Depth 3700**PRODUCTION**

1st 24 hrs. Nat. _____

1st 24 hrs. after shot _____

Gas _____ Cu. Ft.

Dry Hole _____

Abandoned _____

Date

MAR 2 - 1938 19H. D. Hatfield Scout