


DX 78-1 Stafford

KANSAS

Section 4 Township 22S Range 12W

Well No. #1 Stargel

Company Leben

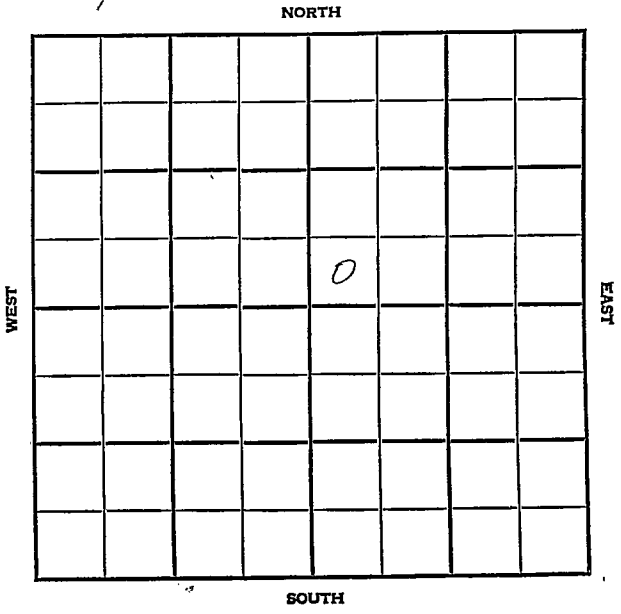

SEC. 4 - -	TWP. 22	R. 12W
---------------	------------	-----------

WELL NO. #1 Stargel FARM

COMPANY
Leben

CONTRACTOR

German Valley


_____ FT. FROM N. LINE

_____ FT. FROM S. LINE

_____ FT. FROM E. LINE

_____ FT. FROM W. LINE

SW SW NE

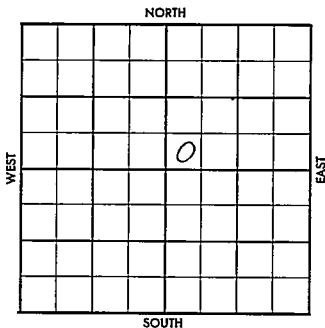

1956	ELEVATION	REPORT
------	-----------	--------

8-22 Location

ABANDONED

County Stafford Elev. _____
 Sec. 14 Twp. 229 Rgs. 12W
 Company Leben
 FarmName Stargel No. 7

TOPS	DEPTH	LOG	DATUM
Anb.			
Tp.			
H.			
Tr.			
Dg.			
Bl.			
L.			
K.C.			
B.K.C.			
Ce.			
C.			
M.			
M.			
K.			
Mz.			
Me.			
V.			
S.			
S.			
A.			
R.			
PE.			
G.			
T.D.			

Loc. in Sec. SW SW NE
 Geol. _____
 Contr. _____
 Pool German Valley

FIRST REPORT		
0		
AUG 22 56		

Date Comm. _____
 Loc. _____

Co. Lse. No. Sec. T. R.

5 R

County Stafford Elev. 1862
 Sec. 4 Temp. 22S Rge. 12W
 Company Leben
 Farm Name Stargel No. 1

TOPS	DEPTH	LOG	DATUM	Loc. in Sec.
Anb.				SW SW NE
Tr.				
H.	3148			
Tr.				
Dg.				
Bl.	3283			
L.	3295			
K.C.				Geol.
B.K.C.				Contr.
Ce.				
C.	3541			
M.				Pool
M.				German Valley
K.				
Mz.				
Mo.				
V.	3547			
S. <i>sh</i>	3589			
S.				
A.	3645			
R.				
Pe.				
G.				
TD.	3654			

SEP 12 '56
 0
 ABANDONED

Date Comm.

Loc. AUG 29 '56 P-23-56 85 1/2
277/225 D 2050 SEP 5 '56 SEP 12 '56
DST 3646-49 1hr 300900 + 50' OGCM
1BHP 170. DEA DST 3647-54
90" 600 625 + 30' OGCM + 200' W
BHP 310/20"
hold for logs
DEA