


Harvey

Form 51-5M-11-31-Palace

Map No. KANSAS Sec. 4 Twp. 22 R. 3W

Well No. 3 Toth Farm
Shell Pet. Corp. Company

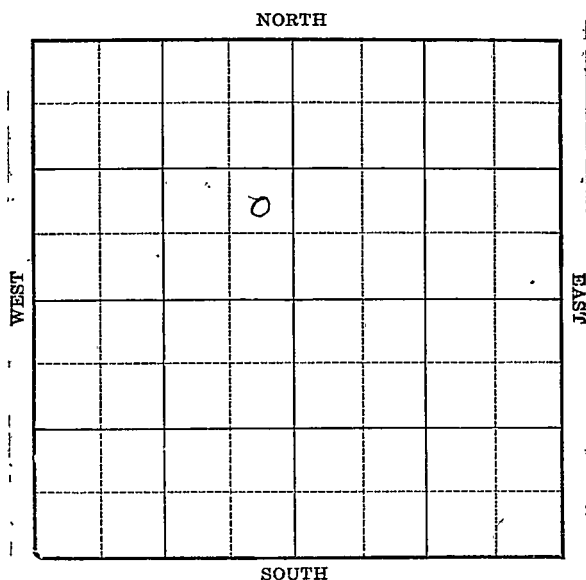

Location

Drilling Remarks

Rig Up

Drilling Remarks

RECORD

Cased _____ in. _____ ft.

Sand _____

Gas _____

Oil _____

Total Depth _____

PRODUCTION

1st 24 hrs. Nat. _____

1st 24 hrs. after shot _____

Gas _____ cu. ft.

Dry Hole _____

Abandoned _____

Harvey

Map No. KANSAS Sec. 4 Twp. 22 R. 3^W

Well No. 3 Voth Farm


Shell Company

 Ft. from N. Line

990' Ft. from S. Line

330' Ft. from E. Line

 Ft. from W. Line

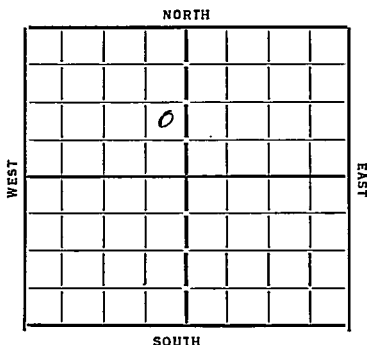

Date 1934

REPORT

1/3 Cellar

1/11 Rigging Rotary

1/17 Drill 650

1/24 " 2189

1/31 —

2/7 Top Chat 3178 Drill 3318

2/14 B. Line 3427 Hutton 3518

TD 3522 Cw. 7" 3518 RUST

2/23 Drill Plug

2/28 Hutton 3518 YD 3531

Pump 818 Bble.

COMPLETED

Map No. 43 Sec. 4 Twp. 22 R. 3N

Well No. 3-Voth

Shell Company

Contractor

FIRST REPORTS

SECTION PLAT

Ft. from N. Line

990 Ft. from S. Line

330 Ft. from E. Line

Ft. from W. Line

	.		
	0		

Location ☒

Rig up

Drilling and Remarks:

RECORD

Cased.....in.,ft.

Sand.....

Gas.....

Oil.....

Total Depth.....

PRODUCTION

1st 24 hrs. Nat.....

1st 24 hrs. after shot.....

Gas.....Cu. Ft.

Dry Hole.....

Abandoned.....

Date

1-3-34 192 O. Mannschreck Scout


Map No. 43 Sec. 4 Twp. 22 R. 3W

Well No. 3-Voth

Shell pet Company

Contractor

SECTION PLAT

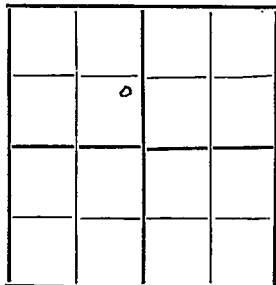

Ft. from N. Line

990 Ft. from S. Line

330 Ft. from E. Line

Ft. from W. Line

COMPLETED

Location

Rig up

Drilling and Remarks:

RECORD

Cased in, ft.

Sand gunter 3518

Gas

Oil

Total Depth 3531

PRODUCTION

1st 24 hrs. Nat.

1st 24 hrs. after shot

Gas Cu. Ft.

Dry Hole

Abandoned

Date

2-28-34 192 O. Manschuet Scout

Pump
818 Hbls