

Map No: KANSAS Sec. 4 Twp 22 R. 3^W

Well No. #1 Uoth Farm


Shell pet Company

_____ Ft. from N. Line

750 Ft. from S. Line

_____ Ft. from E. Line

750 Ft. from W. Line

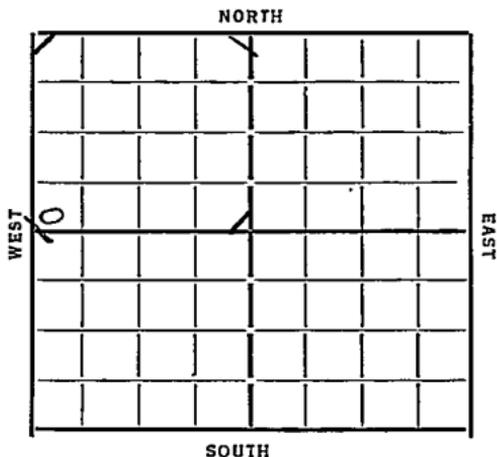

Date
1933

REPORT

- 3/1 R. O. G.
- 3/8 Rigging up Rotary
- 3/15 12" 240 4 Drly 1310'
- 3/22 Drly 2770'
- 3/29 Top Chat 3165 - small show drly 3330
- 4/4 B.L. 3371 Cement 7" 3476 Rest 3479
- 4/12 measured sand 3495-99 750 ton
3499'-3509' swab 250 bbl 3 hrs
- 4/19 No test
- 4/26 7" 3476' sand 3499-3509 J.D.
Potential Prod pump 1854 bbl
24-hrs Completed

Harvey

43 KANSAS

Map No. _____ Sec. 4 Twp. 22 R. 3^w

Well No. 1 Voth

Shell Gas Corp Company

Contractor

FIRST REPORTS


SECTION PLAT

_____ Ft. from N. Line

250 Ft. from S. Line

_____ Ft. from E. Line

250 Ft. from W. Line

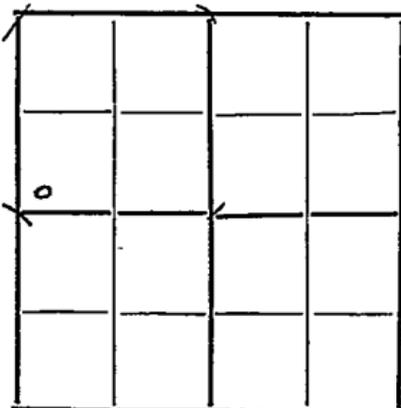

Location _____

Rig up _____

Drilling and Remarks:

Pro. Co.

RECORD

Cased _____ in., _____ ft.

Sand _____

Gas _____

Oil _____

Total Depth _____

PRODUCTION

1st 24 hrs. Nat. _____

1st 24 hrs. after shot _____

Gas _____ Cu. Ft.

Dry Hole _____

Abandoned _____

Date

MAR 1

1933

CHAS. L. SHERWOOD

192

Scout

Harvey

43 KANSAS Map No. Sec. 4 Twp. 22 R. 3 W


Well No. 1 Voth.

Sheep. Pet Co Company

Contractor

COMPLETE

SECTION PLAT

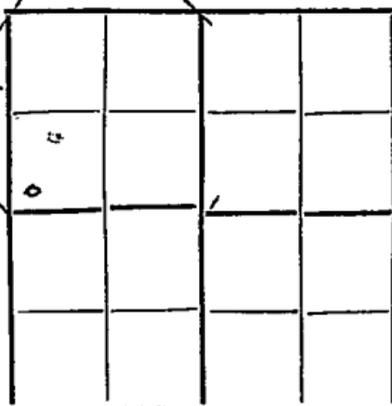

Ft. from N. Line

250 Ft. from S. Line

Ft. from E. Line

250 Ft. from W. Line

Location

Rig up

Drilling and Remarks:

POT Prod

Pump 185.4

Bes 24 hours

RECORD

Cased 7 in., 3476 ft.

Sand 3499-3509

Gas

Oil

Total Depth 3509

PRODUCTION

1st 24 hrs. Nat.

1st 24 hrs. after shot

Gas Cu. Ft.

Dry Hole

Abandoned

Date

APR 26 1933

CHAS. L. SHERWOOD

Scout