


Map No. KANSAS Sec. 4 Twp. 22 R. 3^w

Well No. 1- Hall Farm

Gesur-Ross & Lee Company

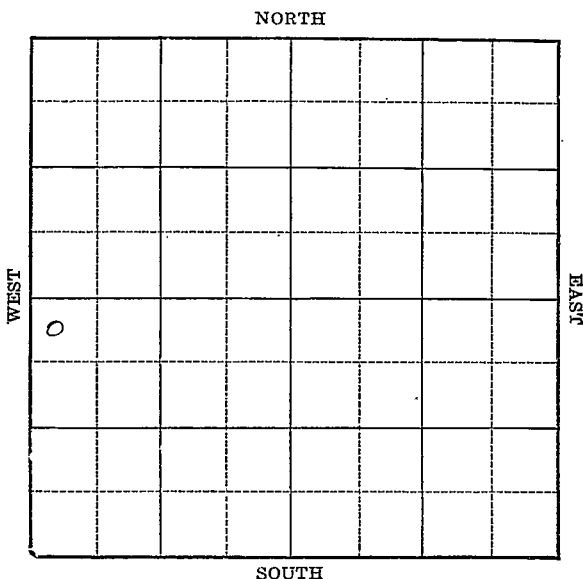

Location _____
Drilling Remarks _____

Rig Up _____
Drilling Remarks _____

RECORD

Cased _____ in. _____ ft.
Sand _____
Gas _____
Oil _____
Total Depth _____

PRODUCTION

1st 24 hrs. Nat. _____
1st 24 hrs. after shot _____
Gas _____ cu. ft. _____
Dry Hole _____
Abandoned _____

Map No. KANSAS Sec. 4 Twp. 22 R. 3^w

Well No. 1-Hall Farm

Greer, Ross & Lee Company


250 Ft. from N. Line

_____ Ft. from S. Line

_____ Ft. from E. Line

250 Ft. from W. Line

1932

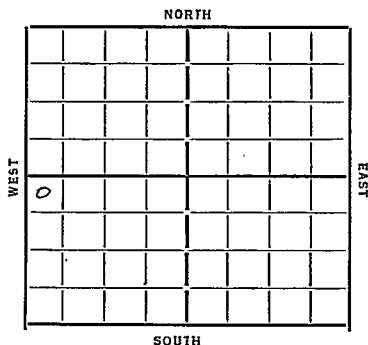

Date

REPORT

11/30	M. I. M.
12/7	Rotary rig
12/14	Run
12/21	Cem 15" 240' woc
12/28	dreg 2170'
1933	
1/4	Top line 3161
	dreg 3170
1/11	Base line 3365'
	Cem 8" 3443
	TD 3447' Rust
1/18	6" 3449
	Top Hunton 3488
	Show oil 3495
	Increase " 3495-3507
	flow by heads
	at 800 to 1000 bbl
	42 gravity at 44
	TD 3507 shut in
	erecting tanks
	(over)

1/25- TD 3507
Run 6" liner 3485
Well dead
Olg out

2/1- TD 3507 No test
Rng tubing

2/8- TD 3507
swab 75 bbl 1 hr
" 110 " 1 "
" 139 " 1 "

swabbing 1100' off bottom
pump 42½ bbl 1 hr
S.D.

2/15- TD 3507
On four hour test
pump 45 bbl first hour
" 31 " second "
" 42½ " third "
" 42½ " fourth "

2/22- TD 3507
pump 516 bbl 14½ hr
3/4 Pump 528 bbl 15 hrs 516 bbl
14 hrs - 809 bbl 19 hrs

3/8- 8" 3443' - Newton 3488'-3507'
TD 3507' show oil 3495'
Increase 3495'-3507'
Potential Prod. Pump
1262 bbl 24 hrs

Harvey

W

43 KANSAS

Map No. _____ Sec. 4 Twp. 28 R. 3

Well No. 1 Hall

Reser, Bass & Lee Company

Contractor

FIRST REPORTS


SECTION PLAT

250 Ft. from N. Line

_____ Ft. from S. Line

_____ Ft. from E. Line

250 Ft. from W. Line

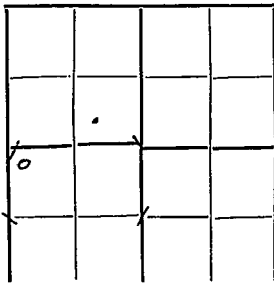

Location _____

Rig up _____

Drilling and Remarks:

Moving in
material

RECORD

Cased _____ in. _____ ft.

Sand _____

Gas _____

Oil _____

Total Depth _____

PRODUCTION

1st 24 hrs. Nat. _____

1st 24 hrs. after shot _____

Gas _____ Cu. Ft.

Dry Hole _____

Abandoned _____

Date

NOV 30 1932

CHAS. L. SHERWOOD

192

Scout

43

KANSAS

Map No. _____ Sec. 4 Twp. 22 R. 3Well No. 1 NallPreser, Ross & Lee Company_____
Contractor

COMPLETED

250 Ft. from N. Line

_____ Ft. from S. Line

_____ Ft. from E. Line

250 Ft. from W. Line

SECTION PLAT

0			

Location _____

Rig up _____

Drilling and Remarks:

Show Oil 3495
increase 3495-3507

Potential Good
Pump 1262 Bbls
24 hours.

RECORD

Cased 18 in., 3443 ft.Sand Hunter 3488-3507

Gas _____

Oil _____

Total Depth 3507

PRODUCTION

1st 24 hrs. Nat. _____

1st 24 hrs. after shot _____

Gas _____ Cu. Ft.

Dry Hole _____

Abandoned _____

Date

MAR 8 1933

192

CHAS. L. SHERWOOD

Scout