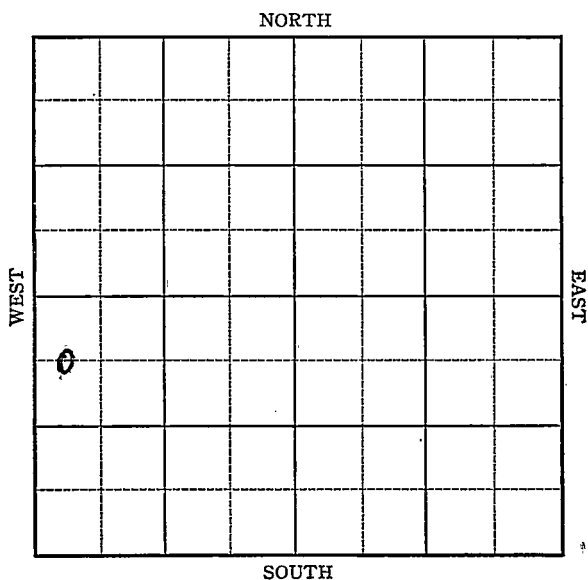


Reno KANSAS

Section 4 Township 22 Range 4-WWell No. 1 DyckCompany Central Petroleum et al

KANSAS


Reno

Sec. 4 Twp. 22 R. 4-WWell No. #1 Dyck FarmCentral Petr. et al Company

(Wildcat)

660 Ft. from N. Line Ft. from S. Line Ft. from E. Line330 Ft. from W. Line

Elev. 1471

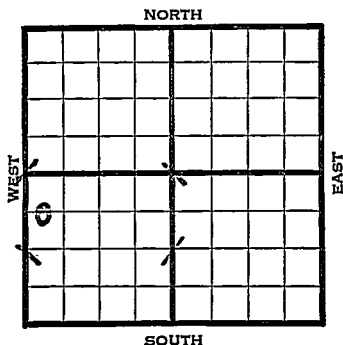

1941

REPORT

6/18

Location

6/26

10" - 175' Drlg. 1785'

7/3

Drlg. 2805'

7/10

Lens. 2640' Miss. 3340'

Drlg. 3501'

7/17

Drlg. 3722'

7/23

Arb. 3974'

T.D. 4004'

No shows.

ABANDONED

$$\begin{array}{r} 3974 \\ 14 \overline{) 1411} \\ \underline{14} \\ 11 \\ 11 \\ \underline{11} \\ 0 \end{array}$$

$$\begin{array}{r} 3371 \\ 11 \overline{) 3371} \\ \underline{33} \\ 71 \\ \underline{71} \\ 0 \end{array}$$

Map No. 48 Sec. 4 Twp. 22 R. 4WWell No. 1 DyckCentral Petroleum etal Company
FIRST REPORT

Contractor

SECTION PLAT


C W L NW SW
660 Ft. from N. Line

_____ Ft. from S. Line

_____ Ft. from E. Line

330 Ft. from W. Line

WILDCAT

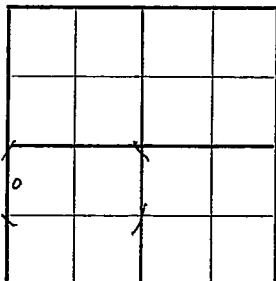Location X

Rig up _____

Drilling and Remarks:

RECORD

Cased _____ in., _____ ft.

Sand _____

Gas _____

Oil _____

Total Depth _____

PRODUCTION

1st 24 hrs. Nat. _____

1st 24 hrs. after shot _____

Gas _____ Cu. Ft.

Dry Hole _____

Abandoned _____

Date

JUN 18 1941 19S. J. LEWIS Scout

Map No. 48 Sec. 4 Twp. 22 R. 4WWell No. 1 DyckCentral Petroleum etal Company~~ABANDONED~~

Contractor

SECTION PLAT

C W L NW SW

660 Ft. from N. Line

Ft. from S. Line

Ft. from E. Line

330 Ft. from W. Line

o			

WILDCAT

Location

Rig up

Drilling and Remarks:

*See 83974**No show*

RECORD

Cased _____ in., _____ ft.

Sand _____

Gas _____

Oil _____

Total Depth 4004

PRODUCTION

1st 24 hrs. Nat. _____

1st 24 hrs. after shot _____

Gas _____ Cu. Ft.

Dry Hole _____

Abandoned _____

Date

JUL 23 1941

19

S. J. LEWIS Scout