

KANSAS

Pawnee

Section 4 Township 22 Range 17W

Well No. 1 Frizzell

Company Vickers & Gulf

Wildcat
NORTH

0							

WEST

EAST

SOUTH

KANSAS

Pawnee



Sec. 4 Twp. 22 R. 17W

Well No. #1 Frizzell Farm

Vickers & Gulf Company

Wildcat

Ft. from N. Line

330'


Ft. from S. Line

Ft. from E. Line

330'

Ft. from W. Line

SW NW

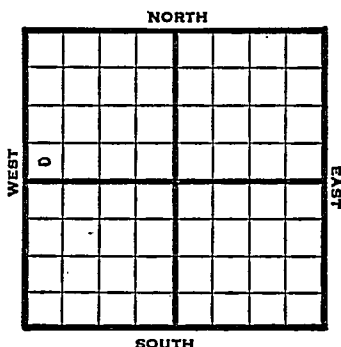

1949

Elev. 2028' REPORT

3/9

RUR

3/16

8" @ 1064'

3/23

DrLg 3375'

3/30

Lanss 3565'

Simp 3974

Arbuckle 3979'

TD 4040'

ABANDONED

Map No. _____ Sec. 4 Twp. 22 R. 17WWell No. 1 Frizzell

Vickers & Gulf

Company

FIRST REPORT

Contractor

SW NW

SECTION FLAT

_____ Ft. from N. Line


330

_____ Ft. from S. Line

_____ Ft. from E. Line

330

_____ Ft. from W. Line

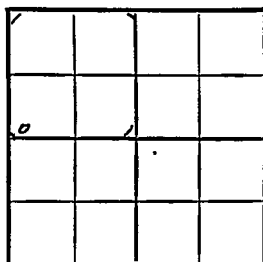

Pawnee County

Location _____

Rig up _____

Drilling and Remarks:

R U R

RECORD

Cased _____ in., _____ ft.

Sand _____

Gas _____

Oil _____

Total Depth _____

PRODUCTION

1st 24 hrs. Nat. _____

1st 24 hrs. after shot _____

Gas _____ Cu. Ft.

Dry Hole _____

Abandoned _____

Date

MAR 9 1949 19

S. J. LEWIS

Scout

Kansas

Map No. 81 Sec. 4 Twp. 22 R. 17WWell No. 1 Frizzell

Vickers & Gulf

Company


ABANDONED

Contractor

SW NW

E 12031

SECTION PLAT

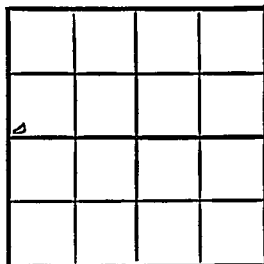 Ft. from N. Line330 Ft. from S. Line Ft. from E. Line330 Ft. from W. Line

Pawnee County

Location Rig up

Drilling and Remarks:


RECORD

Cased in., ft.Sand Gas Oil Total Depth 4040

PRODUCTION

1st 24 hrs. Nat. 1st 24 hrs. after shot Gas Cu. Ft.Dry Hole Abandoned

Date

MAR 30 1949

19

S. J. LEWIS

Scout