


KANSAS
Range **29W**

Section **4** Township **22**

Well No. **#1 Baumann**

Company **Shell**

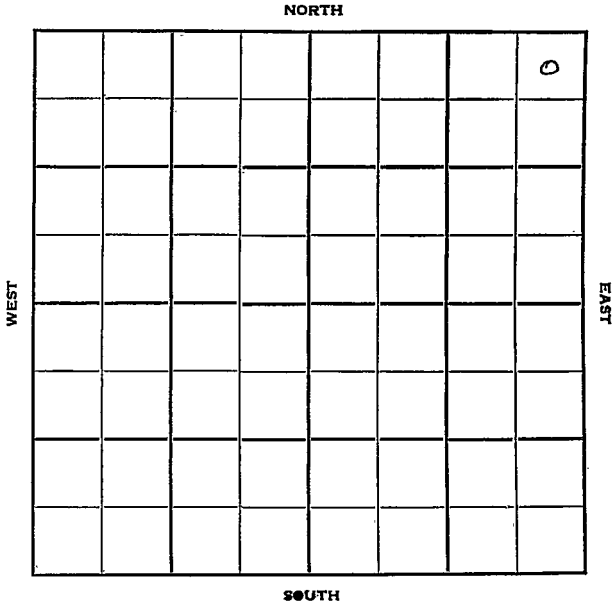

Sec. 4 Twp. 22 R. 29 W ✓

Well No. # 1 Baumann Farm

Shell Company

Herndon Drlg. Contractor

Wildcat


330 Ft. from N. Line

 Ft. from S. Line

330 Ft. from E. Line

 Ft. from W. Line

NE NE NE

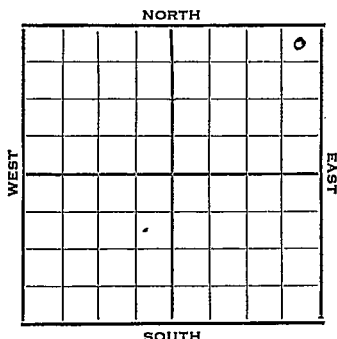

1951

Elev. 2660' REPORT

Arb. Test

11/28

Location

1952

2/6

Drlg. 3835 Ft. Riley 2680
Cottonwood 3007 Topeka 3526
DST 3570-3614 1 hr 450' SW
Heeb 3792

2/13

Lans. KC 3829'
DST 4296-4328', 1 hr, 15' M
Drlg. 4408'

2/20

Miss. 4516'
DST 4695-4703 1 hr. 20' m
Drlg. 4763'

3/5

Ran Schl at 4056 Simp 5200
Arb. 5297
DST 5297-5317 1 hr. 3060'
black sulp wtr RTD 5347 Rung schl.

3/12

Spud 1-19-52
D & A TD 5347' 9" @ 501'
Hol. 2499' Kri 2562'
DST 2519-78 open 1 hr, rec 95' mud
Ft. Riley 2680' Cottonwood 3007'
Top 3526'
DST 3570-3614 open 1 hr, rec 450' SW
Heeb 3792' Lans. 3829'
DST 4296-4328 open 1 hr, rec 15' mud
Miss 4516'

OVER

1952

3/12

(Information continued)

DST 4695-4703 open 1 hr. rec 20' mud
Osage 4814' Simp. 5200' Arb. 5297'

DST 5297-5317 open 1 hr. rec 3060'
black sul. water. TD 5347'

DST 5000-5035 open 1 hr. rec 900' sul
water.

DST 4904-35 open 1 hr. rec 30' mud
D & A

ABANDONED

County Finney State Kansas
 Sec. 4 (Blk.) 22 (Sur.) 29W Map No.

Operator Shell

Well No. 1 Farm Baumann

Elev. _____ Location NE NE NE

FIRST REPORT

330 Ft. From N Line NE

330 Ft. From E Line Quarter

1st. Report NOV 28 1951

Completion _____

Remarks _____

Spudding Date _____

Drig. Data Wildcat

Location (Arb test) _____


J. E. TYRA

County Finney State
 Sec. 4 (Blk.) (Sur.) Map No. 29W
 (Twp.) 22 (Rge.) 29W

Operator Shell

Well No. 1 Farm Baumann

Elev. 2660 Location NE NE NE

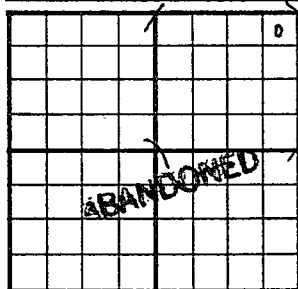

330 Ft. From N Line NE

330 Ft. From E Line Quarter

1st. Report

Completion MAR 1 2, 1952

Remarks Wildcat

Herndon Drlg. - Contr.

Spudding Date 1-19-52

Drlg. Data D & A TD 5347

9" @ 501 Hol. 2499 Kri. 2562

DST 2519-78 open 1 hr. Rec. 95' mud

Ft. Riley 2680 Cottonwood 3007

Top. 3526 DST 3570-3614 open 1 hr.

Rec. 450' sw Heeb. 3792 Lans. 3829

DST 4296-4328 open 1 hr. Rec. 15' mud

Miss. 4516 ✓ DST 4695-4703 open 1 hr.

Rec. 20' mud Osage 4814 Simp. 5200

Arb. 5297 DST 5297-5317 open 1 hr.

Rec. 3060' black sul. water TD 5347

DST 5000-5035 open 1 hr. Rec. 900'

sul. water DST 4904-35 open 1 hr.

Rec. 30' mud

D & A