


Stafford

KANSAS

SECTION 5 TOWNSHIP 22 RANGE 13W

WELL NO. #1 Schmidt "A"

COMPANY Birmingham & Bartlett

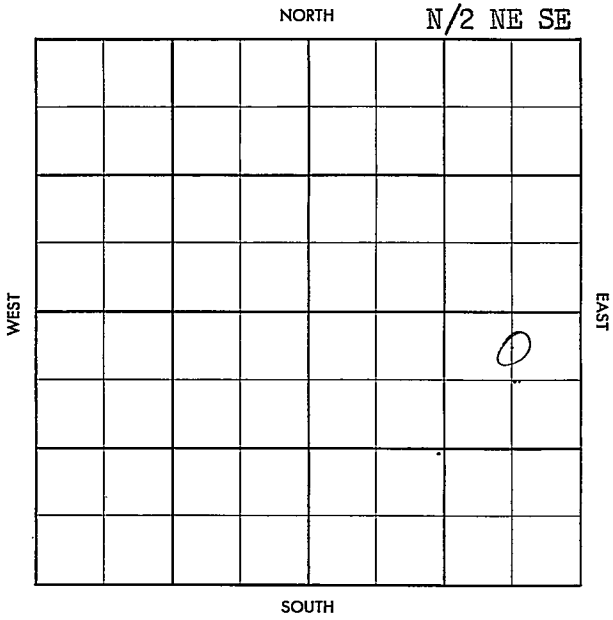

County Stafford Elev. \_\_\_\_\_  
 Sec. 5 Twp. 22 Rgs. 13W  
 Company Birmingham & Bartlett  
 Farm Name Schmidt "A" No. 7

TOPS	DEPTH	LOG	DATUM	Loc. in Sec.
Anh.				<u>N<math>\frac{1}{2}</math> NE SE</u>
TP.				
H.				
Tr.				
Dg.				
Bl.				
L.				Geol. P. <u>Jennings</u>
K.C.				Contr.
B.K.C.				<u>Co. Tools</u>
Ce.				Pool
C.				<u>Hufford</u>
M.				
M.				
K.				
Mz.				
Me.				
V.				
S.				
S.				<u>FIRST REPORT</u>
A.				
R.				
PE.				
G.				
T.B.				

APR 24 1957

Date Comm. 4-18-57  
8" @ 281/200, Drlg. 3015

13

Co.  
Lse.  
No.  
Sec.  
T.  
R.

County Stafford Elev. 1901  
 Sec. 5 Twp. 22 Rge. 13W  
 Company Birmingham & Hartlett  
 Farm Name Schmidt "A" No. 1

TOPS	DEPTH	LOG	DATUM	Loc. in Sec.
Anh.	759			N <sup>1</sup> NE SE
Tr.				
H.	3242			
Tr.				
Dg.				
Bl.	3375			
L.	3386			Geol. F. Jennings
K.C.				Contr.
B.K.C.				
Ce.				
C.	3654			Co. Tools
M.				
M.				Pool
K.				
Mz.				Hufford
Mo.				
V.	3674			<div style="border: 1px solid black; padding: 5px; text-align: center;"> <p><b>ABANDONED</b></p> <p>MAY 1 '57</p> </div>
S.	3724			
S.				
A.	3774			
R.				
PE.				
G.				
T.B.	3778			

Date Comm. 4-18-578" @ 281/200, Drlg. 3075 MAY 1 57DST 3406-18 1hr rec 185'Mdy SW + 550 BHP 905/20"DST 3650-81 1hr rec 43' Md+ 550 BHP 110/20" DST 3775-782 hrs 590' sulp wtr BHP1220/20"DEA.