

Stafford KANSAS

Section 5 Township 22 Range 14 WWell No. # 2 EstesCompany Natural Gas & Oil & Sinclair

NORTH

		0					

WEST

EAST

SOUTH

Stafford

KANSAS ✓

Sec. 5 Twp. 22 R. 11W

Well No. #2 Estes Farm

Natural Gas & Oil & Sinclair Company

Natural Gas Contractor


 Ft. from N. Line

330 Ft. from S. Line

990 Ft. from E. Line

 Ft. from W. Line

SW SE NW

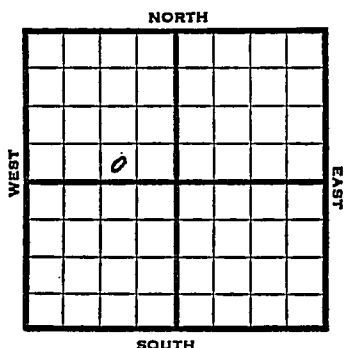

1953 Elev. 1958' REPORT

6/17	Loc.
6/24	"
7/1	8" @ 263 Drlg. 3265'
7/8	Elec. log tops: Heeb 3330' Lans 3460 DST 3574-91, 1 hr, 12' SOCM DST 3589-3627, 1 hr, 100' OCM, 600' oily MCW 980# DST 3639-49, 1 hr, 45' OCM 320# 320# Viola 3749 Simp 3801' DST 3819-35, 1/2 hr, 8' M Arb. 3856 DST 3858-66, 1 hr, 300' gas, 810' clear gassy oil, 60' frothy oil 990## RTD 3874 5" @ 3873
7/22	72/3858-68, S/11 boph, 500A, S/17 boph POP
7/29	Spud 6-23-53 Oil well TD 3874 8" @ 263 Heeb 3330 Lans 3460 DST 3574-91 open 1 hr rec 12' SOCM DST 3589-3627 open 1 hr rec 100' OCM 600' oily MCW 980# DST 3639-49 open 1 hr rec 45' OCM 320# Viola 3749 Simp 3801 DST 3819-35 open 1/2 hr rec 8' mud

OVER

1953
7/29

(Information continued)

~~XXXX~~ Arb. 3856

DST 3858-66 open ~~XXXXXXX~~ 1 hr.

rec ~~XXXX~~ 300' gas, 810' clean gassy
oil, 60' frothy oil 990#

TD 3874 5" @ 3873 72/3858-68

S/11 BOPH 500 A S/17 BOPH

Comp. 532 BOPD

COMPLETED

J. G. McGEHEE

J. G. McGEHEE