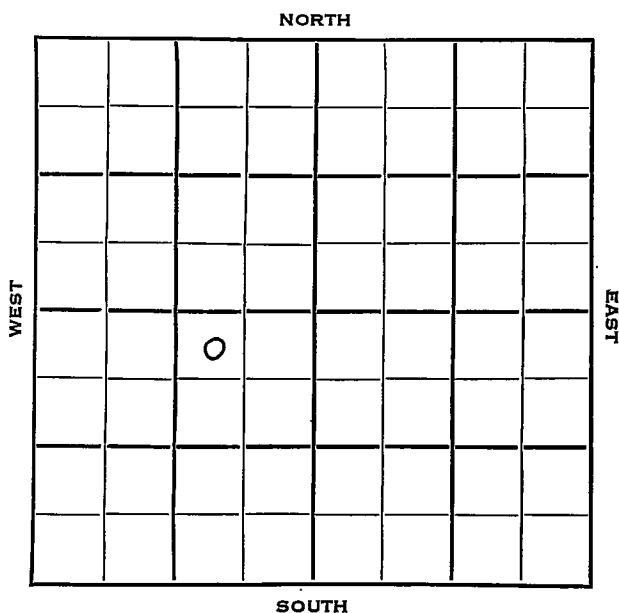


Section 5 Township 22 Range 14WWell No. #1 MorrisonCompany Natural Gas & Oil & Sinclair

~~SEXXXX~~

Stafford

KANSAS ✓

Sec. 5 Twp. 22 R. 14 WWell No. # 1 Morrison FarmNatural Gas & Oil & Sinclair Company

Contractor

Radium Townsite Pool

330

Ft. from N. Line

Ft. from S. Line


990

Ft. from E. Line

Ft. from W. Line

NW NE SW

NORTH

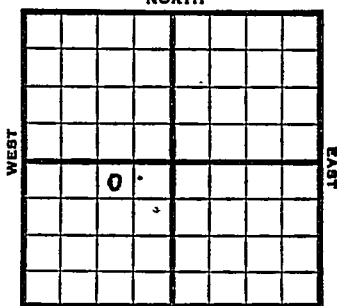

SOUTH

1953

Elev. 1956' REPORT

8/19

Location

8/26

10" @ 270 w/225

Drlg. 1672'

9/2

Anhy 885, Heeb 3334, Br. L. 3453, Lans 3462

DST 3592'-3600' $\frac{1}{2}$ hr, 3' M

Drlg 3601'

9/9

V. 3752'

DST 3756-71 1 hr, 20' M, Simp 3806'

DST 3806-41 1 hr, 25' M Arb 3864,

DST 3967'-75' 1 hr, 90' gas, 480'

frothy oil, 60' mco, 1380#

RTD 3975'

7" @ 3875'

9/16

CO 3876 TD Cor

FU 740' oil 3 hrs.

S/10 BOPH 10 hrs., POP

9/23

N.R.

OVER

1953

10/14

Spud 8-22-53 Oil well TD 3876
10" @ 270 Anhy 885' Heeb 3334
Br. lime 3453 Lans 3462
DST 3592-3600 open $\frac{1}{2}$ hr rec 3' mud
Viola 3752
DST 3756-71 open 1 hr rec 20' mud
Simp. 3806
DST 3806-41 open 1 hr rec 25' mud
Arb. 3864
DST 3867-75 open 1 hr rec 90' gas,
480' frothy oil, 60' MCO 1380#
TD 3875 7" @ 3874 CO to 3876
FU 740' oil 3 hr. S/10 BOPH
10 hr.
Comp. 429 BOPD 4% wtr.

COMPLETED

County **Stafford** State **Kansas**

Sec. 5 (Blk. Twp.) 22 (Sur. Rge.) 14W Map No.

Operator **Natural Gas & Oil & Sinclair**

Well No. 1 Farm Morrison

Elev.	Location	NW	NE	SW
-------	----------	----	----	----

FIRST REPORT

330 Ft. From N Line SW

990 Ft. From R Line Quarter

1st. Report AUG 19 1953

Completion


Remarks

Spudding Date

Drlg. Data Radium Townsite Pool

Location

County Stafford State Kansas
 Sec. 5 (Blk.) 22 (Sur.) 14W Map No.
 Operator Natural Gas & Oil & Sinclair
 Well No. 1 Farm Morrison
 Elev. 1956 Location NW NE SW

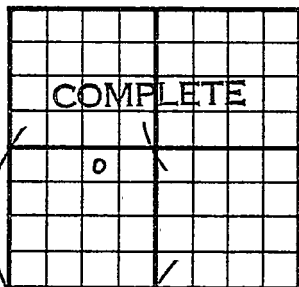

330 Ft. From N Line SW
990 Ft. From E Line Quarter
 1st. Report
 Completion OCT 14 1953
 Remarks Radium Townsite Pool

Drilg. Data Oil well TD 3876
 Spudding Date 8-22-53

10" @ 270 Anhy 885 Heeb. 3334
Br. lime 3453 Lens. 3462 DST 3592-3600
open $\frac{1}{2}$ hr. Rec. 3' mud Viola 3752
DST 3756-71 open 1 hr. Rec. 20' mud
Simp. 3806 DST 3806-41 open 1 hr.
Rec. 25' mud Arb. 3864 DST 3867-75
open 1 hr. Rec. 90' gas 480' frothy oil
60' mco 1380# TD 3875 7" @ 3874
CO to 3876 FU 740' oil 3 hr.
S/ 10 boph 10 hr. Comp. 429 bopd 4% wtr

J. G. McGEHEE