

Section 5 Township 22 Range 11 WWell No. #2 LongCompany B. R. Lauck

NORTH

					0		

WEST

EAST

SOUTH

Stafford

KANSAS

SEC.	TWP.	R.
5	22	14W

WELL NO.

#2 Long

FARM

COMPANY

D. R. Lauck

CONTRACTOR

Co. Tools


Strobel

_____ Ft. from N. Line

_____ Ft. from S. Line

_____ Ft. from E. Line

_____ Ft. from W. Line

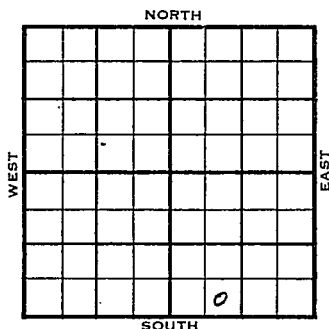

SE SW SE

1955	ELEVATION	REPORT
	1950 KB	
8/24	Comm 8-18-55 8" @ 228/200 Anh 876 Drlg 2425	
8/31	Comm 8-18-55 Anh 876 H 3345 BI 3465 L 3473 C 3767 V 3779 S 3830 A 3881 3881 TD 3895 8" @ 228/200 DST 3847-65 open 1/2 hr Rec 10' mud 0/15" DST 3881-84 open 1/2 hr Rec 10' mud 810/20" DST 3883-98 open Rec 15' mud 720# DST 3887-95 open 1 hr Rec 70' thi wtry mud 1050/20" D & A	
ABANDONED		

X

County Stafford Elev. _____
 Sec. 5 Twp. 22 Rge. 11W
 Company D. R. Lauck
 Farm Name Long No. 2

TOPS	DEPTH	LOG	DATUM
Anh.	876		
Tr.			
H.			
Tr.			
Dg.			
BL.			
L.			
K.C.			
B.K.C.			
Ce.			
C.			
M.			
M.			
K.			
Mz.			
Ma.			
V.			
S.			
S.			
A			
R.			
PE			
G.			
T.D.			

Loc. in Sec. _____
 S E S W S E

Geol. _____
 Contr. _____
 Co. tools _____
 Pool _____
 Strobe? _____

FIRST REPORT
 AUG 24 1954
 0

Date Comm. 8-18-55
8" @ 228/200 drlg. 2h25

[Handwritten signature]

Co.
Lse.
No.
Sec.
T.
R.

५

ABANDONED