


Stafford

KANSAS

DX 78-1

Section 5 Township 22S Range 11W
Well No. #2 Morrison
Company Natural G & O & Sinclair

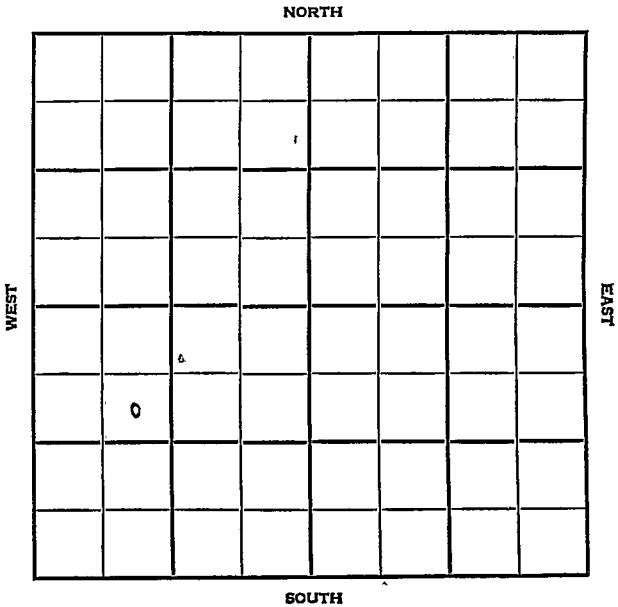

Stafford KANSAS

SEC.	TWP.	R.
5	22 S	14 W
WELL NO.		
# 2 Morrison FARM		
COMPANY		
Natural G & O & Sinclair		
CONTRACTOR		

Radium Townsite


990 Ft. from N. Line

Ft. from S. Line


Ft. from E. Line

990 Ft. from W. Line

SE NW SW

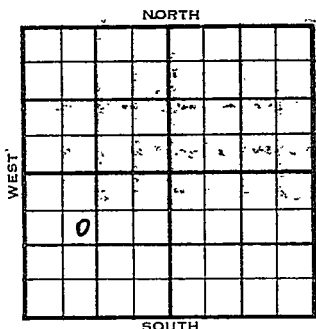

1954	ELEVATION	REPORT
12/8	1955'	RURT
1955 1/26		Spud 12-8-54 Oil Well TD 3879' 8" @ 290' Heeb 3338', Br. Lime 3455' Lans 3464' B KC 3698' Viola 3757' DST 3805'-40' opn 45 min, rec 30' Mud off DST 3865'-71' opn 1½ hr, rec 130' ocm 900# DST 3871'-77' opn 1 hr, rec 1580' oil 1000# TD 3877' 5" @ 3874' DD 3879' S/ 53 ½ bo 5 hr. S/ 8.35 boph 3 hr. P/ 92 bo 13% Wtr. Comp 99 bopd. 14 bw. Schlumberger Tops: Heeb 3332', Br. Lim 3452' Lans 3462' B KC 3696' Viola 3740' Simp 3810' Arb. 3864' COMPLETED

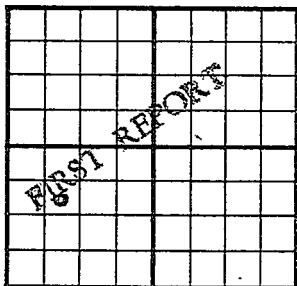County Stafford State KansasSec. 5 (^{Blk.}_{Twp.}) 22S (^{Sur.}_{Rge.}) 14W Map No.Operator Natural G & O' & SinclairWell No. 2 Farm MorrisonElev. Location SE NW SW990 Ft. From N Line.990 Ft. From W Line SW Quarter1st. Report DEC 8 1954

Completion


Remarks

Spudding Date

Drlg. Data Radium TownsiteRURT

FABEN GILSTRAP

County Stafford State Kansas
 Sec. 5 (Blk. 22 (Sur. 14W Map No.
 (Twp.) (Rge.)
 Operator Natural Oil & Gas & Sinclair
 Well No. 2 Farm Morrison
 Elev. 1955 Location SE NW SW

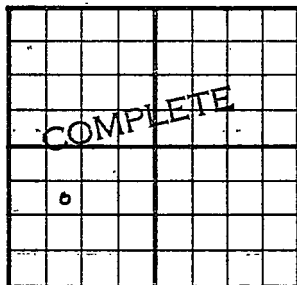

990 Ft. From N Line SW
 990 Ft. From W Line Quarter

1st. Report

Completion JAN 26 1955

Remarks

Radium Townsite Pool

Spudding Date 12-8-54

Drlg. Data Oil well TD 3879
8" @ 290 Heeb. 3338 Br. lime 3455
Lans. 3464 B KC 3698 Viola 3757
DST 3805-40 open 45 min. Rec. 30' mud
0# DST 3865-71 open 1½ hr. Rec. 130'
ocm 900# DST 3871-77 open 1 hr.
Rec. 1580' oil 1000# TD 3877
5" @ 3874. DD 3879 S/ 53½ bo 5 hr.
S/ 8.35 boph 3 hr. P/ 92 bo 13% wtr.
Comp. 99 bopd 14 bw

SCHLUMBERGER TOPS:

Heeb. 3332 Br. lime 3452 Lans. 3462

B KC 3696 Viola 3740 Simp. 3810

Arb. 3864

FABEN GILSTRAP