


Map No. **KANSAS** Sec. **5** Twp. **22** R. **11W**
 Well No. **1- A. J. Groves** Farm
Empire Oil Company

NORTH

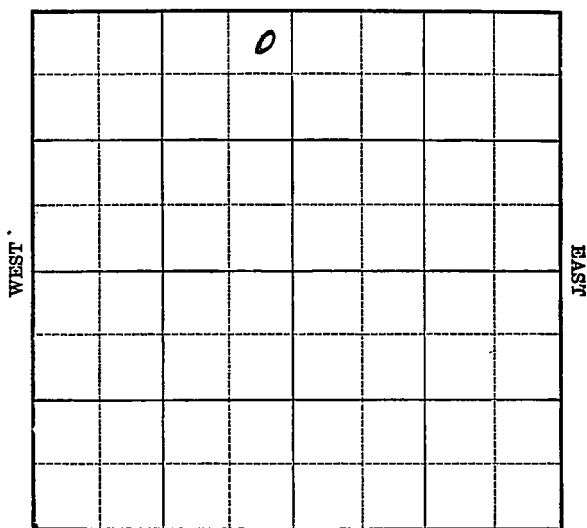

SOUTH

Location _____
 Drilling Remarks _____

Rig Up _____
 Drilling Remarks _____

RECORD

Cased _____ in. _____ ft.
 Sand _____
 Gas _____
 Oil _____
 Total Depth _____

PRODUCTION

1st 24 hrs. Nat. _____
 1st 24 hrs. after shot _____
 Gas _____ cu. ft.
 Dry Hole _____
 Abandoned _____


Map No. KANSAS Sec. 5 Twp. 22 R. 11W
Well No. 1- A. J. Grover Farm
Empire Oil Company

330 Ft. from N. Line

 Ft. from S. Line

330 Ft. from E. Line

 Ft. from W. Line

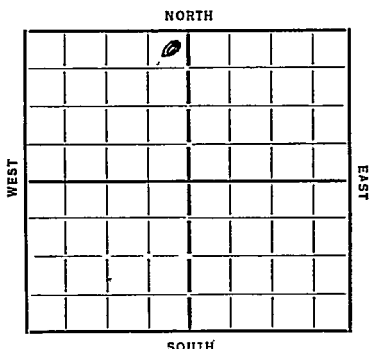

Date 1935 REPORT

5/1 Location
5/9 Bldg Rot Rig
5/16 20" 38
5/23 Bldg 750 15" 491
5/29 " 1395 12" 1345
6/6 12" collapsed 1295
6/13 1635 Splicing Wireline
6/20 Bldg 1984 10" 1925
6/28 " 3090
7/3 " 2615
7/11 " 2690 10 2454
7/18 8" 2770 HFW 2815
8/8 Bldg 3142
Cong 3425
Bld 3460-63
Run pipe S.O.
8/15 Bldg 3455 HFW 3486
6" 3494
8/21 Bld 3507 T7 3518
20 ft.

ABANDONED

Map No. 46 Sec. 5 Twp. 22 R. 11WWell No. 1- P. J. KroesEmpire oil Company

Contractor

FIRST REPORTS**SECTION PLAT**330 Ft. from N. Line

..... Ft. from S. Line

330 Ft. from E. Line

..... Ft. from W. Line

		0	

Location ✓

Rig up.....

Drilling and Remarks:

RECORD

Cased.....in.,ft.

Sand.....

Gas.....

Oil.....

Total Depth.....

PRODUCTION

1st 24 hrs. Nat.....

1st 24 hrs. after shot.....

Gas.....Cu. Ft.

Dry Hole.....

Abandoned.....

Date

ORVAL MANNSCHECK5-1-35 192..... Scout

Map No. 46 Sec. 5 Twp. 22 R. 11W

Well No. 1-S. J. Brown

Empire oil Company

Contractor

ABANDONED

SECTION PLAT

330 Ft. from N. Line

Ft. from S. Line

330 Ft. from E. Line

Ft. from W. Line

	0		

Location

Rig up

Drilling and Remarks:

RECORD

Cased in, ft.

Sand oil 3507

Gas

Oil

Total Depth 3518

PRODUCTION

1st 24 hrs. Nat.

1st 24 hrs. after shot

Gas Cu. Ft.

Dry Hole

Abandoned

Date

8-21-35 192

ORVAL MANNS

Scout