


Section 5 Township 22 Range 12 W

Well No. 1 Alpers

Company Palmer Oil

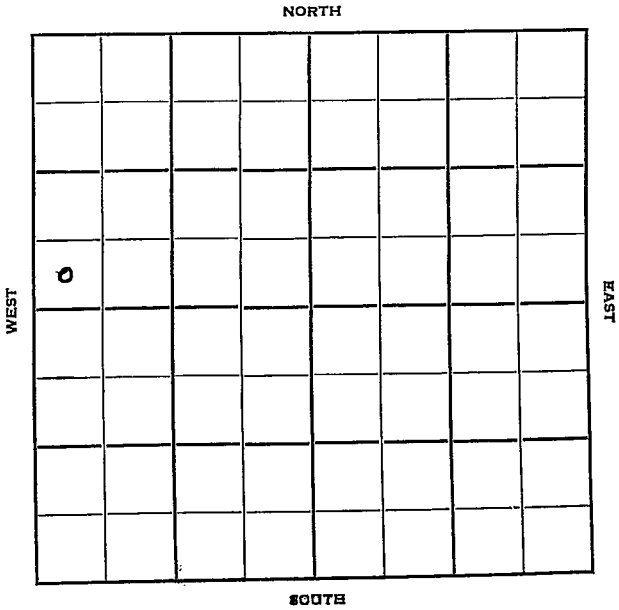

Stafford

KANSAS

5

22

12W

Sec. Twp. R.

Well No. #1 Alpers Farm

Palmer Oil

Company

Contractor

Wildcat

330'

Ft. from N. Line


Ft. from S. Line

Ft. from E. Line

330'

Ft. from W. Line

SE SE NW

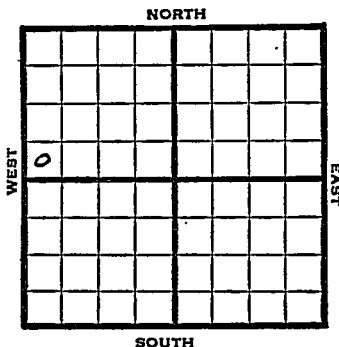

1950

Elev 1870

REPORT

5/17

Spud 5-11-50
8-5/8" @ 245'
Anhy. 700-18
Drlg. 2675'

5/24

8 5/8" @ 245
Anhy 700-18
Br lime 3322
Lans 3340
Cong 3581
TD 3700
D&A

ABANDONED

Map No. _____ Sec. 5 Twp. 22 R. 12WWell No. 1 AlpersPalmer Oil Company_____
Contractor


SE SE NW

SECTION PLAT

330 Ft. from N. Line

_____ Ft. from S. Line

_____ Ft. from E. Line

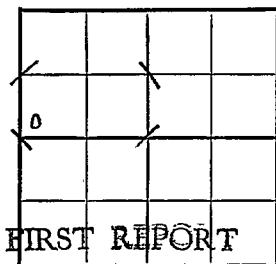330 Ft. from W. Line

FIRST REPORT

Stafford

Location _____

Rig up _____

Drilling and Remarks:

Spud 5-11-50

8 5/8" @ 245

Anhy. 700-18

Drlg. 2675

RECORD

Cased _____ in., _____ ft.

Sand _____

Gas _____

Oil _____

Total Depth _____

PRODUCTION

1st 24 hrs. Nat. _____

1st 24 hrs. after shot _____

Gas _____ Cu. Ft.

Dry Hole _____

Abandoned _____

Date

MAY 17 1950
19

J. E. TYRA Scout

1-1823

Map No. _____ Sec. 5 Twp. 22 R. 12Well No. 1 AlpersPalmer Oil Company


Contractor

SE SE NW

E. 1870
SECTION PLAT330 Ft. from N. Line

_____ Ft. from S. Line

_____ Ft. from E. Line

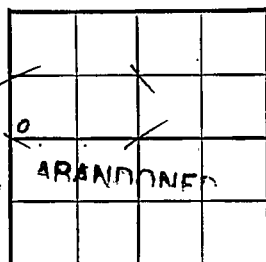330 Ft. from W. Line

Stafford

Location _____

Rig up _____

Drilling and Remarks:

8 5/8" @ 245
 anky 700-18
 Bu line 3322
 Lams. 3340
 Cong. 3581
 T.D. 3700
 D + A

RECORD

Cased _____ in., _____ ft.

Sand _____

Gas _____

Oil _____

Total Depth _____

PRODUCTION

1st 24 hrs. Nat. _____

1st 24 hrs. after shot _____

Gas _____ Cu. Ft.

Dry Hole _____

Abandoned _____

Date

MAY 2, 1950

J. E. TYRA

19

Scout