


Section 5 Township 22 Range KANSAS 121S

Well No. #1 Hainke

Company Petroleum Inc.

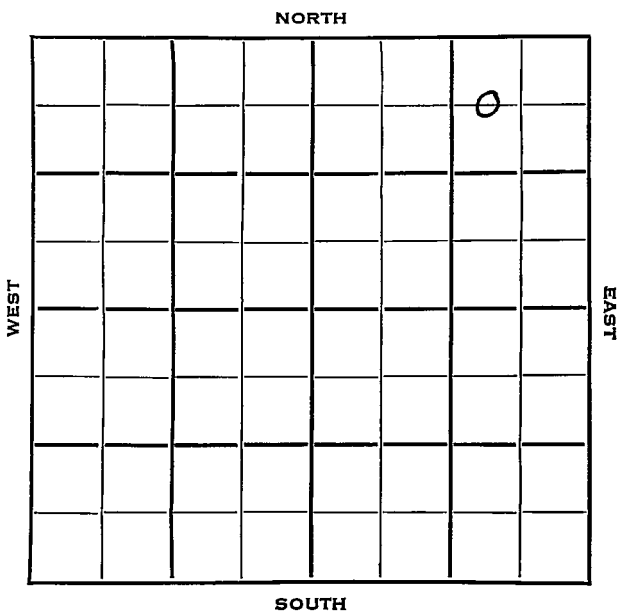

Sec. 5 Twp. 22 R. 12W

Well No. #1 Hainke Farm

Petroleum Inc. Company

Garway Contractor

Semi-Wildcat.


660 Ft. from N. Line

\_\_\_\_\_ Ft. from S. Line

990 Ft. from E. Line

\_\_\_\_\_ Ft. from W. Line

C W/2 NE NE

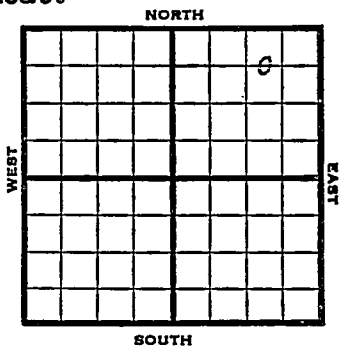

1953 Elev. 1876' REPORT

7/14 MIRT

7/22 8" @ 240 w/200  
Anhy 673  
Drlg. 3355'

7/29 Spud 7-14-53 D & A TD 3677  
8" @ 240 Anhy 673 Heeb 3160  
Br line 3295 Tor. 3180 Lans 3310  
Viola 3558 Simp. 3603 Arb. 3652  
DST 3653-57 open 1 hr rec 50' SW  
575# TD 3677  
D & A

**ABANDONED**

County Stafford State Kansas

Sec. 5 (Blk. Twp.) 22 (Sur. Rge.) 12W Map No.

Operator Petroleum Inc.

Well No. 1 Farm Hainke

Elev. \_\_\_\_\_ Location C W/2 NE NE


660 Ft. From N Line NE

990 Ft. From E Line Quarter

Ist. Report JUL 14 1953

Completion \_\_\_\_\_

Remarks \_\_\_\_\_

Garvey - Contr.

Spudding Date \_\_\_\_\_

Drlg. Data Semi-Wildcat

WIRT

J. G. McGEHEE

