

Harvey

Map No. KANSAS Sec. 5 Twp. 22 R. 3W

Well No. 1 Heibert Farm


Derby Oil Company

_____ Ft. from N. Line

990 Ft. from S. Line

_____ Ft. from E. Line

990 Ft. from W. Line

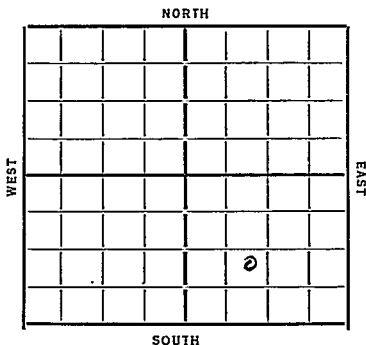

Date
1934

REPORT

<u>3/21</u>	<u>Location</u>
<u>3/29</u>	<u>ROH</u>
<u>4/5</u>	<u>Spud</u>
<u>4/12</u>	<u>delg 2589 15" 297</u>
<u>4/19</u>	<u>Chst 3171 J.O. 3090-99</u> <u>6" 3167 N.O.C.</u>
<u>4/26</u>	<u>J.O. 3350</u>
<u>5/3</u>	<u>B.L. 3400 T Hunter 3507 1/2</u> <u>TD 3510 Run 6 5/8</u>
<u>5/10</u>	<u>delg plug 400' oil</u>
<u>5/18</u>	<u>1000 acid Pump 18 Bbls</u> <u>oil per hr.</u>
<u>5/25</u>	<u>Pump 172 Bbls 21 hrs</u> <u>delg deeper.</u>
<u>5/31</u>	<u>TD 3550 Treated 3 times</u> <u>1000 Gal each Swabbing</u> <u>No test</u>
<u>6/7</u>	<u>117 oil 150 W 24 hrs.</u>
<u>6/14</u>	<u>39 oil + 35 W 6 hrs.</u>
<u>6/21</u>	<u>— 6/28 —</u>
<u>7/5</u>	<u>Recementing pipe</u>
<u>7/12</u>	<u>CO</u>

over

7/19 1000 acid

7/25 Gunton 3507¹/₂

T 1) 3562

1000 acid 366 oil

13 water

COMPLETED

Map No. 43 Sec. 5 Twp. 27 R. 3W

Well No. 1 - Heibert

Derby Oil Company

Contractor

FIRST REPORTS

Ft. from N. Line

990 Ft. from S. Line

Ft. from E. Line

990 Ft. from W. Line

SECTION PLAT

Location

Rig up

Drilling and Remarks:

RECORD

Cased..... in., ft.

Sand.....

Gas.....

Oil.....

Total Depth.....

PRODUCTION

1st 24 hrs. Nat. 2015

1st 24 hrs. after shot.....

Gas..... Cu. Ft.

Dry Hole.....

Abandoned.....

Date

3/21/34 192

O. W. Mannick Scout

KANSAS

Map No. 43 Sec. 5 Twp. 22 R. 3W

Well No. L-Heibert

Herby Oil Company

Contractor

COMPLETED

SECTION PLAT

		0	

_____ Ft. from N. Line

990 Ft. from S. Line

_____ Ft. from E. Line

990 Ft. from W. Line

Location _____

Rig up _____

Drilling and Remarks:

1000 acid

366 oil

13 Water

RECORD

Cased _____ in., _____ ft.

Sand Kuntan 3507 1/2

Gas _____

Oil _____

Total Depth 3567

PRODUCTION

1st 24 hrs. Nat. _____

1st 24 hrs. after shot _____

Gas _____ Cu. Ft.

Dry Hole _____

Abandoned _____

Date

7-25-34 19

ORVAL MANNSCHRECK

Scout