


Map No. **KANSAS**Sec. **5**Twp. **22**R. **3W**Well No. **2****Schmidt**
Shell Pit.

Farm

Company

NORTH

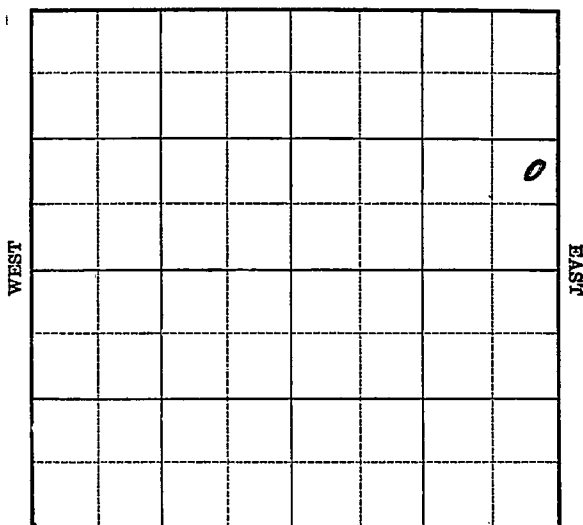

SOUTH

Location _____

Drilling Remarks _____

RECORD

Cased _____ in. _____ ft.

Sand _____

Gas _____

Oil _____

Total Depth _____

Rig Up _____

Drilling Remarks _____

PRODUCTION

1st 24 hrs. Nat. _____

1st 24 hrs. after shot _____

Gas _____ cu. ft.

Dry Hole _____

Abandoned _____


Map No. KANSAS Sec. 5 Twp. 22 R. 3W
Well No. 2 Schmidt Farm
Shell Pet. Company

 Ft. from N. Line

990 Ft. from S. Line

330 Ft. from E. Line

 Ft. from W. Line

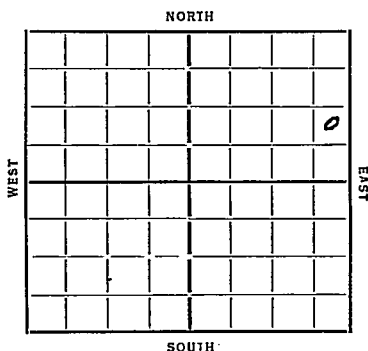

Date 1935

REPORT

2/27 Bldg Rig
3/7 15" 399
3/14 Bldg 1911
3/21 " 2115 10" 544
3/28 " 3150
4/4 " 3422 Chat 3169
4/11 AML 3365 7" 3491 Rust
4/18 Hutton 3495-3505
 T 3519 Sub 15 Bbls 18 hrs.
4/26 1000 acid P 52 Bbls 24 hrs
 P 13 3513
5/2 —
5/15 Hutton 3495 T 3513
 1000 acid 71 Bbls.

COMPLETED

Harvey
 Map No. KAN 43 Sec. 5 Twp. 22 R. 34

Well No. 2 - Schmidt

Shell pet. Company

Contractor

FIRST REPORTS

Ft. from N. Line

990 Ft. from S. Line

330 Ft. from E. Line

Ft. from W. Line

SECTION PLAT

			0

Location

Rig up

Drilling and Remarks:

Bed Rig

RECORD

Cased in., ft.

Sand

Gas

Oil

Total Depth

PRODUCTION

1st 24 hrs. Nat.

1st 24 hrs. after shot

Gas Cu. Ft.

Dry Hole

Abandoned

Date

2-27-35 192 Scout

Map No. 43 Sec. 5 Twp. 22 R. 34Well No. 2-SchmidtShell pet Company

Contractor

COMPLETED

SECTION PLAT

Ft. from N. Line

990 Ft. from S. Line330 Ft. from E. Line

Ft. from W. Line

			0
			.

Location

Rig up

Drilling and Remarks:

1000 acid71 bbls

RECORD

Cased in. ft.Sand Hanton 3495

Gas

Oil

Total Depth 3513

PRODUCTION

1st 24 hrs. Nat.

1st 24 hrs. after shot

Gas Cu. Ft.

Dry Hole

Abandoned

Date

ORVAL MANNSCHRECK

5-15-35 192 Scout