


SECTION 5 TOWNSHIP 22 RANGE 3W

WELL NO. #1 A. Schmidt

COMPANY Don Ingling, etal

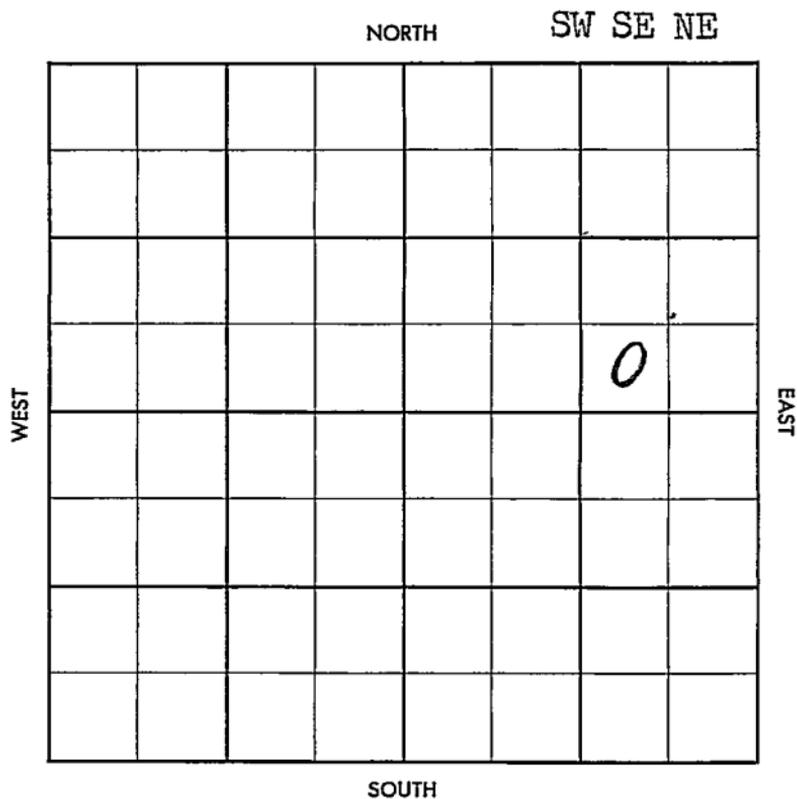

County Warvey

Elev. _____

Sec. 5

Twp. 22

Rgs. 3W

Company Don Ingling, et al

Farm Name A. Schmidt

No. 1

TOPS	DEPTH	LOG	DATUM
Anb. <u>1</u>			
Tr.			
H.			
Tr.			
Dg.			
BL.			
L.			
K.C.			
B.K.C.			
Ce.			
C.			
M.			
M.			
K.			
Mz.			
Mo.			
V.			
S.			
S.			
A.			
R.			
PE.			
G.			
T.D.			

Loc. in Sec. _____

SW SE NE

Geol. _____

Contr. _____

Co. Tools

Pool _____

Hollow-Nikkel

FIRST REPORT

JUN 12 57

Date Comm. 6-9-57

8" @ 270/125, Drlg. 585

Co.
Lse.
No.
Sec.
T.
R.

County Harvey Elev. 1459
 Sec. 5 Twp. 22 Rge. 3N
 Company Don Inrling, et al
 Farm Name A. Schmidt No. 1

TOPS	DEPTH	LOG	DATUM	Loc. in Sec.									
Anh.				SW SE NE									
Tr.													
H.													
Tr.													
Dg.													
Bl.													
L.				Geol.									
K.C.				Contr.									
B.K.C.				Co. Tools									
Ce.				Pool									
C.				Follow-Mikkel									
M.	3161			<table border="1"> <tr> <td colspan="3">COMPLETE</td> </tr> <tr> <td></td> <td></td> <td>0</td> </tr> <tr> <td></td> <td></td> <td>AUG 14 '57</td> </tr> </table>	COMPLETE					0			AUG 14 '57
COMPLETE													
		0											
		AUG 14 '57											
M.	Hunt 2488												
K.													
Mz.													
Ma.													
V.													
S.													
S.													
A.													
R.													
PE.													
G.													
T.D.	3511												

Date Comm. 6-9-57
 8" @ 270/125, Drl. 5'5" JUN 25 '57 @ 2600
 1" 10'57 5 1/2 3508 1/2 WOCT JUN + 5. V
 JUL 10 '57 MICT 1 @ in 2-57
 18/3502-05
 55 oil + wt PB 3205 24/3174
 -78 1/2 \$ 50 Bopd + wt
 P. 25 Bopd + 10 BWpd.

Co.
 Sec.
 No.
 Sec.
 T.
 R.