


Harvey

Form 51-5M-11-31-Palace

Map No. **KANSAS** Sec. 5 Twp. 22 R. 3W

Well No. J-A Schroeder Farm  
Sinclair - Prairie Company

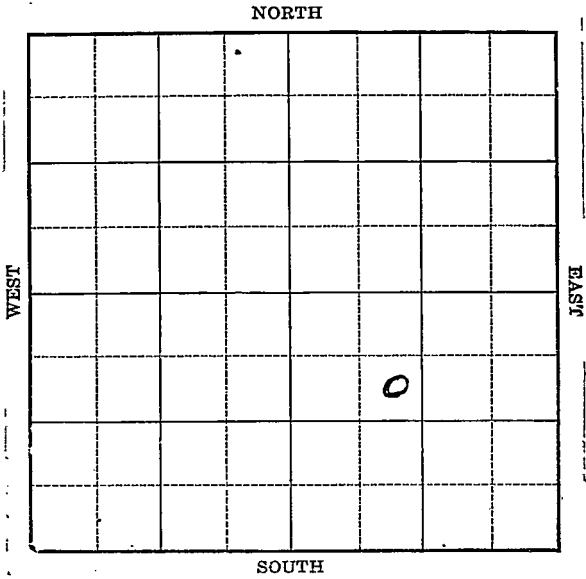

Location .....

Drilling Remarks

.....

.....

Rig Up .....

Drilling Remarks

.....

.....

**RECORD**

Cased ..... in. .... ft.

Sand .....

Gas .....

Oil .....

Total Depth .....

**PRODUCTION**

1st 24 hrs. Nat. ....

1st 24 hrs. after shot .....

Gas ..... cu. ft. ....

Dry Hole .....

Abandoned .....

Harvey

Map No. KANSAS Sec. 5 Twp 22 R. 3 W


Well No. 2-A Schroeder Farm  
Sinclair - Prairie Company

990 Ft. from N. Line

\_\_\_\_\_ Ft. from S. Line

\_\_\_\_\_ Ft. from E. Line

990 Ft. from W. Line

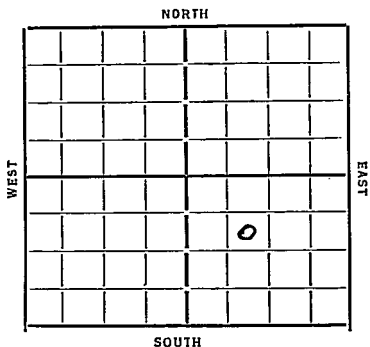

Date 1924

REPORT

5/2 Cellar  
5/10 Rign up  
5/18 \_\_\_\_\_  
5/25 Dlg 2110  
5/31 " 2763  
6/7 " 3496 Chat 3163  
6/14 8" 3505 Rust  
6/27 Huntton 3505 TD 3529  
1000 acid 421 Bbls.

COMPLETED

Map No. 430 Sec. 5 Twp. 22 R. 3W

Well No. 2A-Schroeder

Linclair-prairie Company

Contractor

**FIRST REPORTS**

**SECTION PLAT**

990 Ft. from N. Line

\_\_\_\_\_ Ft. from S. Line

\_\_\_\_\_ Ft. from E. Line

990 Ft. from W. Line

		0	

Location \_\_\_\_\_

Rig up \_\_\_\_\_

Drilling and Remarks:

*cellar*

**RECORD**

Cased \_\_\_\_\_ in., \_\_\_\_\_ ft.

Sand \_\_\_\_\_

Gas \_\_\_\_\_

Oil \_\_\_\_\_

Total Depth \_\_\_\_\_

**PRODUCTION**

1st 24 hrs. Nat. \_\_\_\_\_

1st 24 hrs. after shot \_\_\_\_\_

Gas \_\_\_\_\_ Cu. Ft.

Dry Hole \_\_\_\_\_

Abandoned \_\_\_\_\_

Date

5-2-34

19

*Manuel Scout*

Map No. 43 Sec. 5 Twp. 22 R. 3W

Well No. 2 A Schroeder

Lincoln Prairie Company

Contractor

**COMPLETED**

SECTION PLAT

		0	

990 Ft. from N. Line

\_\_\_\_\_ Ft. from S. Line

\_\_\_\_\_ Ft. from E. Line

990 Ft. from W. Line

Location \_\_\_\_\_

Rig up \_\_\_\_\_

Drilling and Remarks:

1000 acid

421 lbs

RECORD

Cased \_\_\_\_\_ in., \_\_\_\_\_ ft.

Sand Hunter 3505

Gas \_\_\_\_\_

Oil \_\_\_\_\_

Total Depth 3529

PRODUCTION

1st 24 hrs. Nat. \_\_\_\_\_

1st 24 hrs. after shot \_\_\_\_\_

Gas \_\_\_\_\_ Cu. Ft.

Dry Hole \_\_\_\_\_

Abandoned \_\_\_\_\_

Date

6-27-37 19

JORVAL MANNSCHECK

Scout